


Be it remembered that on the ^{12th & 13th} day of April 1871. I was surveying the NE¹/₄ of SW¹/₄ and the NW¹/₄ of SE¹/₄ of Sec: 13 Town 18 Range 2 West by request of the owner of the same Mr Richard Kelley, the SW¹/₄ of SE¹/₄ owned by John Knoblock; the E¹/₂ of SE¹/₄ of said Sec: owned by Pet Mc Roles. The proceedings will be observed from the Diagram and Remarks below.

Remarks

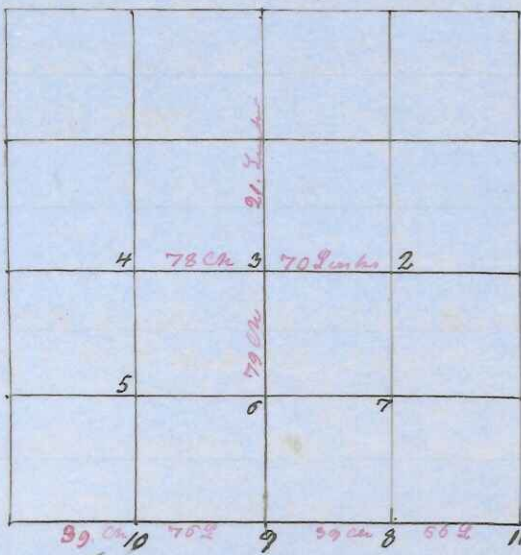


- BT at 1. W Oak 7 N 62 1/2 W 146 & W Oak 7 S 79 1/2 W 23
- " 2 Oak 4 N 63 W 18
- " 3 W Oak 14 S 34 1/2 E 53. R Oak 3 S 17 W 30
- " 4 W Oak 14 S 34 1/2 E 53. R Oak 3 S 17 W 30
- " 5 Heavy 3 N 22 E 13 & W Oak 3 S 21 W 25 1/2
- " 6 W Oak 14 N 25 W 84 & W Oak stump 14 S 73 E 4
- " 7 R Oak 14 N 30 W 46 & R Oak 12 S 39 W 50.
- " 8 R Oak 10 S 20 W 159 & R Oak stump 10 S 51 1/2 W 55
- " 9 Oak 10 S 20 W 159 & R Oak stump 10 S 51 1/2 W 55
- " 10 W Oak 24 N 7 1/2 W 14.
- " 11 W Oak 18 W 57 W 90 & W Oak 10 N 21 W 134

Variation 8°. 4 Rod Chain was used. The gov: corner was adjusted after the field notes. The distances between the gov: corner were carefully measured and leveled equally between each joining. Also the Chances were sworn according to Law. Thereby certify that the proceeding is correct and setd.

O. R. Dahl
Co Surveyor

Be it remembered that on the 12th & 13th day of April 1871. I was surveying the NE¹/₄ of NW¹/₄ & the NW¹/₄ of NE¹/₄ of Sec: 24. Town 18 R 2 W by request of the owner of said Land Mr. Mansman. The Diagram & Remarks

Remarks

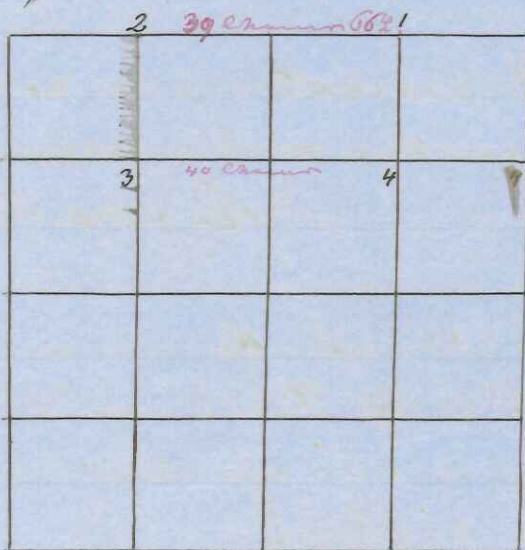

- BT at 1. Oak 10 S 7 N 50 W 88 & R Oak 6 N 79 1/2 W 125
 - " 2 W Oak 24 N 7 1/2 W 140.
- The distance between 3 & 4 was found to be 40 Chain and a line was run between the 2 points which has been established by a former survey

O. R. Dahl

Be it remembered that on the 14th & 15th day of April 1871 I was surveying the NE¹/₄ of NE¹/₄ of Sec: 12 Town 18 R 2 West by request of the owner of the same Mr. Morse. The NE¹/₄ of NE¹/₄ & the NE¹/₄ of NW¹/₄