

Remarks

- 11 BT at 1 WOak 15 N 2 W 130 d Rock 9 S 73 E 06
 12 " " 2 BOak 20 S 8° W 29 d WOak 20 S 62 E 59.
 13 " " 3 WOak 12 S 45 1/2 E 88 d WOak 8 N 81 E 90 1/2
 14 " " 4 WOak 15 N 138 27 d ROak 18 S 82 1/2 W 40.


Variation 8° The government corner was found and adjusted after the field notes and the distance between the some carefully measured and exactly divided between each joining lot. The claimmen were sworn according to Law.

O R Dahl

County Surveyor

A.D. 1871 on the 17th day of April I was surveying the NW of SW 1/4 of Sec. 7 town 18 Range 1 West by request of the owner of said Land Mr David Sullivan. The particulars will be observed from the following Remarks & Diagram

Remarks

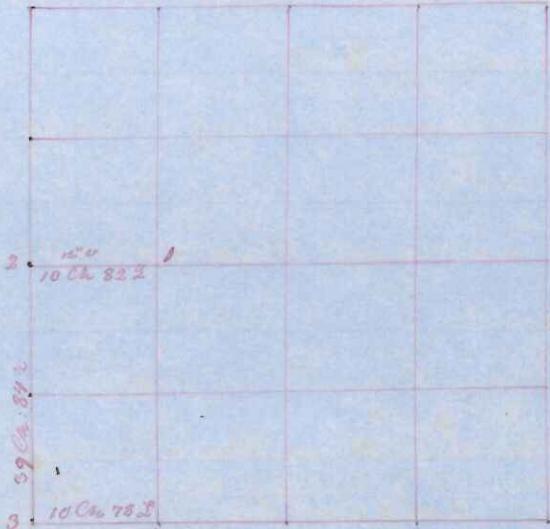

- 14 BT at 1 WOak 16 S 14 1/2 E 130
 15 " " 2 WOak 18 N ^{120 97 1/2} W 53 W 100 ^{4 N 19 W 75}
 " " WOak 12 S 70 W 40.
 24 " " 4 WOak 4 S 32 E 35
 " " WOak 6 N 39 W 20
 25 " " 3 WOak 10 N 52 W 160 d WOak 12 S 70 W 40

Variation on the West side 8° on the N side 10° on the S 8°. The distance was carefully measured and the given corner adjusted after the field notes. Claimmen were sworn according to Law.

O R Dahl

Please remember that on the 26th day of July 1871 I was surveying the NW of NE 1/4 of SW 1/4 Sec. 9 town 18 R 1 West and proceeded as follows toward due

commenced at a stake with B & T BOak 284 S 33 E 38 S. 80 Rods west from the 1/4 Stake in the center of Sec. 9. There in the same direction 20 Rods to a stake with B & T BOak 3 S 82 E 5 S. Then went south to the NW corner of the Murray Ground then west 20 Rods to a Stake with B & T BOak 4 N 71 E 33.