


thence North to the place of bearing
variations 8°. The chainmen were
sworn according to Law.

O R Dahl

County Surveyor

Be it remembered that on the 24th day of
October A.D. 1871 by request of Mr. Lutz I was out
establishing the Sec. Corner of Sections 10, 11, 14 & 15 in Town
16 Range 4 West and proceeded as follows to wit
Commenced at the 1/4 Stk on the line between Sec 10 & 15 then
the distance was carefully measured East with vari-
ation 8.39" 40 Ch thence the distance from the
1/4 Stk on the line between Sec. 14 & 15 was measured
to the 1/4 Stk on the line between 10 & 11 at 6" variation
distance 80 Ch and the said Sec corner was established
at equal distance between these points. The gov-
corners were corrected after the field notes the
chainmen were sworn according to Law. The distance
between the said lost Sec. corner and the 1/4 Stk on the
line between Sec. 11 & 14 was not measured.

For further information see the following
Remarks

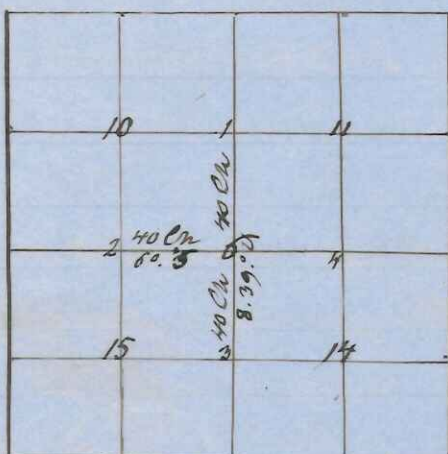

- B T at 1 Birch 4 S 29 W 97 could not be found
- " " 2 B Oak 18 S 20 E 21.97 no other tree near
- " " 4 B Oak 12 S 20 E 21.15 & B Oak 10 S 79 W 105 } the distance between
- " " 3 Position measured pit East 6 L. This } the corner and the
- Stk was found in the middle of the } Sec. corner was not
- Road and has according to Mr. G. Spencer and three } measured.
- persons owning land adjoining it, been retained } since the gov. established the same.
- " " 5 B Oak 10 S 15 W 6.70 no other tree near.
- " " 6 Cottonwood 5 S 70 E 7.69.

Be it remembered that on the 25th day of October
1871 I was establishing the Sec. corner between Sec.
14 15 22 & 23 in town 16 Range 4 West by request of
Mr. W. G. Justice and proceeded as follows to wit
The original bearing trees to this corner was cut down
and removed and by digging up to the ground it was
with certainty found where the said trees have
been standing. then the corner was established ac-
cording to the field notes and new bearing trees
established in these place. as follows

3 dot B Oak 23 & 4 inches in diameter

Indorsed by
H. L. Rice
Surveyor

Indorsed by
H. L. Rice
Surveyor