



Sec. 17, T. 14, R. 16, W. Field notes of a survey of Section 17, Town 14, Range 16, made April 10 1873
 Run from N 1/4 to E 1/4 40.04 chains to center, which is established at the intersection
 of straight 1/4 lines. From west 1/4 N 87 1/2 33.22 ch to center. From center N 87 1/2
 33.70 chains to E 1/4. From center S 11 1/2 W. 40.56 ch to N 1/4 stake ~~from N 1/4 on 1/4 line~~
 From N 1/4 on 1/4 line S 87 W 33.76 ch to N 1/4 on west line. From S.W. corner south
 40.28 chains to west 1/4 stake. ~~Witness trees at the corners of said survey~~
 made by me.

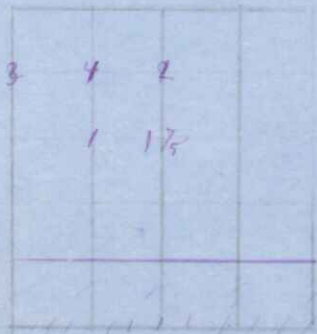

at W 1/4 on 1/4 line 3 1/2 ch out 14 N 35 W 74
 at N 1/4 on 1/4 line 2 1/2 ch out 16 S 60 W 49
 at N 1/4 on west line 3 1/2 ch out 20 S 44 E 42
 at N 1/4 on W 1/4 line 10 ch out 22 East 40
 But center (S 10 ch out 20 S 47 E 127
 post in fence S 39 W 78 1/2
 This 14th day of
 April 1873
 A. J. Ingalls Co. Surveyor.

Sec. 1, T. 15, R. 9, W. Field notes of survey of Section 1, T. 15, R. 9, W. made April 12 1873
 Run from W 1/4 stake N 87 1/2 40.36 chains to center, which is established at
 the intersection of straight 1/4 lines. From center N 87 1/2 33.22 ch to E 1/4. From
 N 1/4 South 40.16 ch to center. From center South 40 chains to South 1/4 stake
 From N 1/4 on 1/4 line N 87 W 40.56 ch to N 1/4 on west line. From W 1/4 South 33.70 ch to
 S.W. corner. From N 1/4 N 87 W 40.56 chains to S.W. corner. From W 1/4 N 87 1/2 40.36 chains
 to S.W. corner. From E 1/4 stake on 1/4 line N 87 W 33.73 chains to E 1/4 on 1/4 line
 From N 1/4 on 1/4 line west 40.42 chains to N 1/4 on W line. From N 1/4 S 87 E 40
 chains to S.W. corner. ~~Witness trees at the 1/4 corners as established by me,~~
 all 1/4 stakes established at proportional distance from ~~then~~ the stakes or called with other of them.

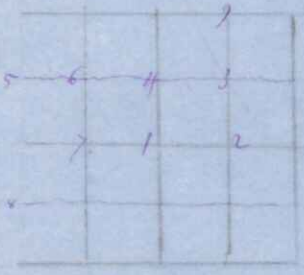

at center 1 1/2 ch out 16 N 77 W 14
 at E 1/4 on 1/4 line 2 1/2 ch out 10 S 13 E 10
 at N 1/4 on E 1/4 line 3 1/2 ch out 10 S 64 W 12 1/2
 at N 1/4 on 1/4 line 4 1/2 ch out 16 S 73 E 56
 at N 1/4 on W line 5 1/2 ch out 5 S 50 W 19
 at N 1/4 on W 1/4 line 6 1/2 ch out 15 S 53 W 45
 at W 1/4 on 1/4 line 7 1/2 ch out 14 S 80 W 32
 at N 1/4 on W line 8 1/2 ch out 5 S 50 E 28
 at E 1/4 on N line 7 1/2 ch out 12 S 89 W 150

at N 1/4 stake ~~the~~ witness trees established by
 at the S.W. ^{at the S.W.} government ~~the~~ evidently bears at West instead of S.W. as recorded in the
 minute for in the spotting on the tree points to the E, S and taking the
 minute as they read make section 2 short 2 1/2 chains & sec 11 plus the same
 variation of north side course record from true meridian
 Witness my hand this 18 day of April 1873
 A. J. Ingalls Co. Surveyor