


Sec. 1, T. 15, R. 4, W

Field notes of a survey of section 1, T. 15, R. 4, W as made by me May 12<sup>th</sup> 1873  
 Run from W 1/4 & 31.70 chains to center which is established at the intersection of  
 straight 1/4 lines. From center east 40.26 ch to E 1/4 stake. From S.E. corner West  
 40.38 ch to E 1/4. From E 1/4 S 62° E 45.57 ch to center. From center S 52° E 37.60 ch  
 to S 1/4 stake. From S.W. corner S 2° W 44.65 ch to W 1/4. From W 1/4 S 11° E 32.68 chains  
 to S.W. corner. From S 1/4 W line S 62 1/2° E 37.62 ch to S 1/4 on 1/4 line. From S 1/4  
 on 1/4 line S 87 1/2° E 40 chains to S 1/4 on E line. From E 1/4 South 40 ch to S.E. corner  
 From S 1/4 on W line east 33.56 ch to S 1/4 on 1/4 line. Courses reckoned from  
 true meridian variation S 2° E. All eighth corners established  
 at proportional distances from the corners on each side of them.

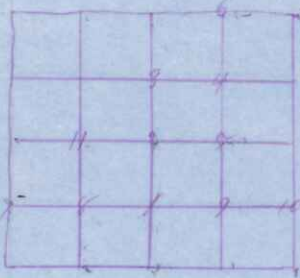

- Witness trees at the corners established by me
- 1 at S 1/4 stake on 1/4 line B, oak 10 S 20 E 23
  - 2 at center - no tree near for witness
  - 3 at S 1/4 stake on 1/4 line W, oak 10 S 71 E 31
  - 4 " E 1/4 " " S 1/4 line W, oak 10 S 65 E 26
  - 5 " E 1/4 " " on 1/4 line B, oak 10 S 35 W 20 1/2
  - 6 " E 1/4 " " on E line W, oak 16 S 46 W 6
  - 7 " S 1/4 " " on W line W, oak 12 S 72 E 19
  - 8 " S 1/4 " " on W 1/4 line W, oak 12 S 56 W 24
  - 9 " S 1/4 " " on E 1/4 line B, oak 10 S 14 W 31
  - 10 " S 1/4 " " on east line W, oak 16 S 23 W 26
  - 11 " W 1/4 " " on 1/4 line W, oak 10 S 17 E 42

Witness my hand this 13<sup>th</sup> day of May 1873  
 A. S. Purgelle Co. Surveyors.

Sec. 1, T. 15, R. 1, W

Field notes of section No 1, T. 15, R. 1, W as run by me June 17<sup>th</sup> 1873  
 From S 1/4 S 85° E 37.20 ch to S.E. corner. From S.E. corner S 52° E 40.41 to E 1/4 stake  
 From E 1/4 on S line S 74° E to E 1/4 on 1/4 line. From S.E. corner S 85° E 40.00 ch to S 1/4  
 From W 1/4 on S line S 2° W 37.75 ch. to W 1/4 on 1/4 line. From center S 83° W 40.12 ch to W 1/4.  
 From W 1/4 S 52° W 40.26 ch to S.W. corner. From S 1/4 on W line 37.50 ch to S 1/4 on 1/4 line  
 Courses reckoned from true meridian. Variation of needle S 2° E.

- Witness trees at corners established by me.
- at S 1/4 on 1/4 line W, oak 24 S 33 E 36
  - at center of section (B, oak 15 S 67 E W 21  
W, oak 14 S 62 E 12)
  - at S 1/4 on E line (Jack oak 30 S 15 W 42  
W, oak 16 S 55 E 40)
  - " E 1/4 on S line W, oak 20 S 48 E 40
  - " W 1/4 on 1/4 line B, oak 18 S 43 E 15
  - " S 1/4 on W line B, oak 30 S 45 W 35
  - " S 1/4 stake on 1/4 line B, oak 16 S 25 W 22

Witness my hand this 17<sup>th</sup> day of June 1873  
 A. S. Purgelle Co. Surveyors.