


Dec 7 1897

Surveyed this 19th and 23rd days of Jan 1897
 for owners of lands in said section Messrs Smith, Welch,
 Green, Abbott and others; Commencing at post at
 corner of Town of Redgerville. Tallow Sheldon & Hellington
 Variation 6° 30' East Distinct Sea line two links East
 of Sea corner, corrected variation 5° 15'. Thence south 320 rods. Sea post
 gone. Found original bearing tree, blown, reestablished Sea post
 from bearing tree, made new bearing tree, thence 50 ch at temp
 orary post. Returned to N W corner of lot near East variation 4° 30'
 1/4 post 60 feet north of line, corrected variation 6° 15' set 1/4 post in
 edge of Pond; cropped pond banks very abrupt. 80 ch to Sea
 corner. corner gone found original bearing tree. W oak found
 from corner found B tree. Made new bearing, thence 3 on over 5' 10
 and struck temporary Sea post made two bearing trees
 As the several lines were corrected, 1/4 and 1/4 posts were established
 between 1/4 post and found by running from 1/4 post to 1/4 post
 from W to E, then from E to N.

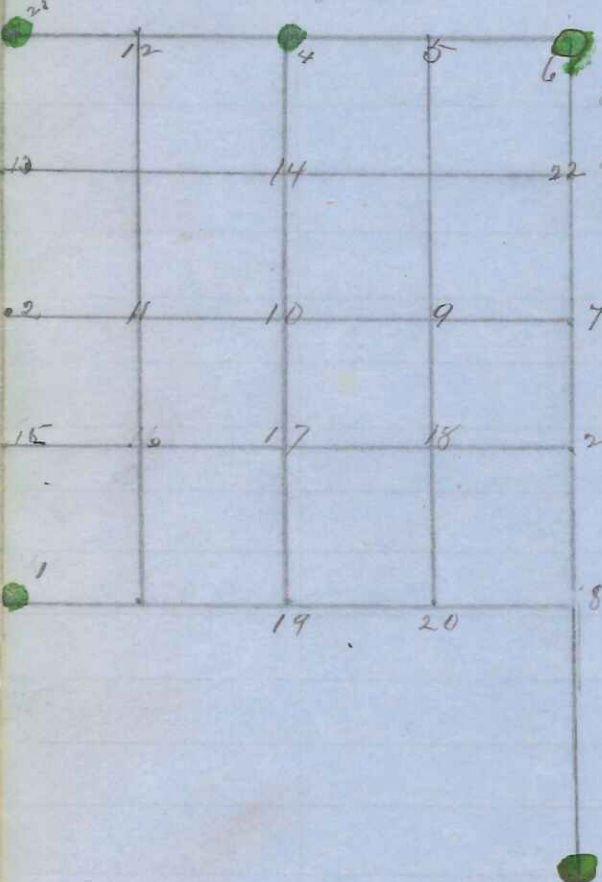

Returned to 1/4 post between Sec 17 & 18 being a known
 corner bearing tree still standing in run north to N E
 corner of Sec 7 and found our line correct.
 Walnut tree at 1 Elm N 33° E 10 (original)

Harrison La Rue
 Co. Surveyor

- " " " " Butternut 10 S 52° W 80 Links
- (2) Red oak 16 N 33 1/2° W 50
- " " Oak 8 N 22° E 17 1/2
- (4) W Birch 12 S 6° W 40
- Pine stump N 10 E 43
- (5) W Pine 8 S 24° W 14 1/2
- (6) W oak 12 N 45° E 75 3/4 } 6
- (8) W oak 12 N 10 1/2° E 62 } 3
- Scrub 5 N 82° E 89 } 3
- (7) W oak 10 S 1° W 22
- " " 8 S 87° W 87 3/4
- (8) Pine stump 24 N 41° W 89
- S Maple 12 S 14° E 105 1/2
- (9) Burn oak 5 S 89° E 58 3/4
- (10) Elm 14 N 28° W 111
- (11) W Pine 6 N 53 1/2° W 24
- (12) Ash 5 S 18° E 47
- (13) Sugar 6 S 49° W 17 1/2
- (14) Elm 24 S 76 1/2° W 52 1/2
- (15) Elm 14 N 22 1/2° W 48 1/2
- (16) Oak 4 S 1° E 6
- (17) W oak 6 S 86° W 24
- (18) Cottonwood 27 S 74° E 241
- (19) S Maple 12 N 18° W 42 1/2
- Cleft in sand rock W 63
- (20) Burn oak 5 N 49° E 30 1/2
- (21) Elm 12 S 47° W 38 3/4
- (22) Black oak 8 44° W 10 Links } 3
- (23) Cherry tree } 48 1/2
- Soft maple 142 Links East } 3