


Sec 36 + 25  
T. 19 R. 4 N.

Surveyed this 1<sup>st</sup> day of April 1897 the tract 1/2 of the North  
Tract 1/4 of Sec 36 and the E 1/4 of the E 1/4 of Sec 25 of Town 19, R. 4 Tract  
for Mrs. Sumner.

Commenced on Town Line at corner of Secs 35 and 36, found spot  
and on original bearing line. Made one new bearing line B oak 12 787 to  
54 1/2 links thence North, Variation 6° E, 80 rods set 1/8 post, thence 80 rods  
set 1/4 post, thence 80 rods, set 1/8 post, thence 80 rods to Sec corner of Secs  
25, 26, 35 + 36, thence North 80 rods to 1/8 post, thence East 79 rods 17 links  
and set 1/8 post.

Returned to 1/4 post between 35 + 36, run E, Variation 5° 15' E, 79 rods 17 1/2 links  
thence and set 1/8 post, thence North, Variation 5° E, 80 rods, and set post on 1/8 link  
thence North 80 rods set post on sec line, thence North 80 rods and attached  
1/8 link of Sec 25 found feet East of temporary post. Connected E and made B  
line along said 1/8 link

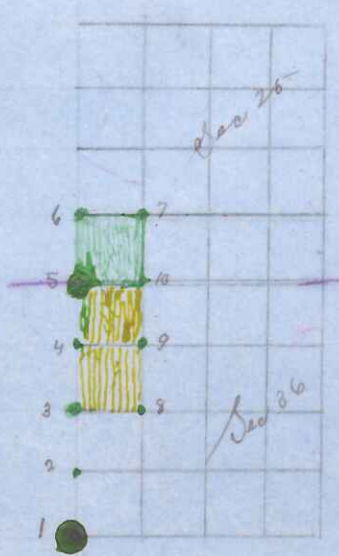

|      |          |    |             |              |
|------|----------|----|-------------|--------------|
| At 1 | 1/8 post | 12 | N 87° W     | 54 1/2 links |
| " 2  | 1/8 post | 20 | S 58° E     | 103 "        |
| " 3  | 1/8 post | 12 | W 48° W     | 73 "         |
| " 4  | 1/8 post | 7  | S 58° W     | 59 "         |
| " 5  | 1/8 post | 10 | S 47° W     |              |
| " 6  | 1/8 post | 4  | S 86° W     | 124 "        |
| " 7  | 1/8 post | 4  | S 4° W      | 170 "        |
| " 8  | 1/8 post | 10 | S 18° E     | 66 "         |
| " 9  | 1/8 post | 14 | W 15° E     | 62 "         |
| " 10 | 1/8 post | 7  | W 18° W     | 42 "         |
| " 11 | 1/8 post | 4  |             | 29 1/2 "     |
| " 12 | 1/8 post | 4  | S 89 1/2° E | 47 3/4 "     |
| " 13 | 1/8 post | 4  | W 81° W     | 59 1/2 "     |

I hereby certify that the foregoing are correct copy of field notes of  
and survey

Hamilton La Rue  
C. Sawyer