


Sec 36
Town 19, 4W

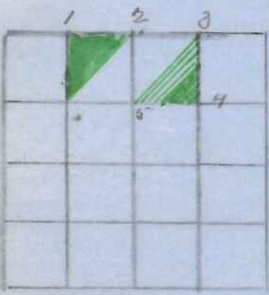


Surveyed for C. F. Mengel this 2nd day of April 1897 the
the NE 1/4 of the N 1/4 and the N 1/4 of the NE 1/4 of Sec 36 Town
19 North of Range 4 West. Commenced at N corner of the NE 1/4 of
the NW 1/4 of Sec 35. thence East 79 rods and 17 links, ~~and set 1/4 post~~ ^{to} set line
between 25 and 36 thence East 79 rods + 17 links and set 1/4 post thence
South 80 rods and set post. thence West 79 rods and 17 links and set post
thence West 79 rods + 17 links to 1/8 post established Apr 1st at SE corner
of the N 1/4 of N 1/4 of Sec 36

Bearing. Post at

1	Black oak	4	S 89 1/2 E	47 1/4 Links
"	Jack pine	4	N 81 W	59 1/2 "
"	W oak	6	S 18 E	57 "
"	W "	14	N 20 W	122 "
"	B oak	12	N 71 E	111 "
"	B "	12	N 8 W	85 "
"	B "	"	N 85 W	59 "
"	W "	8	S 26 W	42 "
"	B "	6	N 10 E	82 "
"	B "	4	"	29 1/2

No 6. got out and stilled as could not be deciphered
Retired my hand officially at Willow this 2nd day of
Apr 1897
Hamilton La Rue
C. F. Mengel

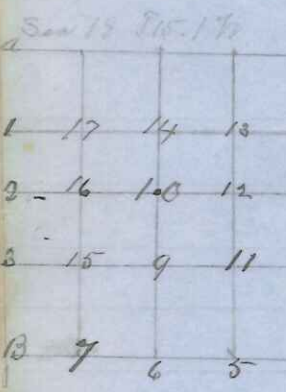

Surveyed and sub-divided Sec 17 Town 15 Range West
for resident owners, Mepu Abbott, Guitz, Mitchell, Dougherty
Brommberg and Rhodes. Chainman sworn according to law
at original Bearing

at 12 ash	S 32 W	26 Links
" 13 maple	N 38 W	21 "
" 15 Red oak	S 51 W	35 "
" 16 "	oak S 72 1/2 E	28 "
" 17 Maple	S 20 E	27 "
" 14 Cherry	S 49 1/2 W	23 1/4 "
" 1 Stemlock	S 31 W	56 "
" 4 Elm	S 86 W	111 S. Cherry 3 S 80 E 25 1/2 S) opposite 1/4 corner.
" 5 W oak	S 74 1/2 W	26 L
" 6 R oak	N 84 1/2 E	2 1/4 Links
" 7 Sugar Maple	N 12 1/4 W	18 L
" 8 Elm	N 80 E	24 L
" 9 Elm	S 89 E	70
" 10 W Pine	S 30 E	20 S. Red oak 6 S 12 W 46 1/2
" 11 R oak	S 88	46

Center of Sec was found by
running straight line from
May 18 1897
Recorded June 1st 1897
H. La Rue
C. F. Mengel