


Sec 27
T. 17 N Range
3 West

Resurvey and sub-division of Section 27 Town 17 North
of Range 3 West, made by H. P. Schroeder Dep Co Surveyor the
20th & 23rd of April 1897 for W. Rhode

Commenced at corner of Sections $\frac{26}{27}$ $\frac{24}{25}$ North between Sec
26 & 27 at 40 ch found $\frac{1}{4}$ post, Bearing True 18 back out 10 N 20° 31' 5" (1)
Black " 12 N 28° 8' 32"

at 80 ch set Temporary Sec post. Thence West between 26 & 27
at 89.60 ch set temporary $\frac{1}{4}$ sec post. Pine 21 S 81° 1/2 E 266 Links (2)
at 79.29 set temporary Sec post - found 15 oak marked S 2
- was a stake set

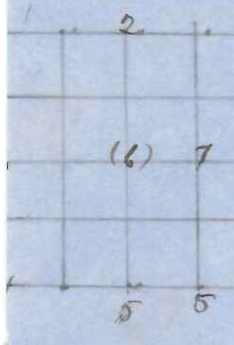

South between 27 & 28
at 40.03 found old $\frac{1}{4}$ post. (18 ? B. oak " N 42° E 32 L) (3)
" " " 10 S 65° 24' W 185 L) (3)
at 80.06 15 oak 9 in N 31° W 35 L + W oak stump 12 N 17° E 90 L (11)

Old stake was a little South of this point and set new post.
East between 27 & 34 at 40.06 at 46.06 set temporary $\frac{1}{4}$ post found no
bearing true.

at 60.09 set temporary $\frac{1}{4}$ post at 80.60 intersected E boundary of
Sec 27. 94 Links North of post (3-c)

West corrected set $\frac{1}{8}$ post 70 Links S and 36 Links
South at 40.20 set $\frac{1}{4}$ post S 47 and S 24 Links

Black oak 12 N 44° E 127 Links (5)
North on $\frac{1}{4}$ line from $\frac{1}{4}$ post on S side of Sec 27

at 40 ch set temporary $\frac{1}{4}$ post. 80 ch intersected N Sec line 68
Links East of $\frac{1}{4}$ post. South corrected at 40.00 set Temporary

Temporary Sec Line stake 84 Links West at 80 set $\frac{1}{4}$ post
West on center line from $\frac{1}{4}$ post on E side of 27

20.00 set $\frac{1}{4}$ post (Temporary)
40.00 " $\frac{1}{4}$ " " "

79.74 intersected W boundary 30 $\frac{3}{4}$ Links S of post
S corrected

at 39.87 set our center $\frac{1}{4}$ post 18 $\frac{3}{4}$ Links North and 18 Links E
& intersected N T S $\frac{1}{4}$ center line & set $\frac{1}{4}$ center post (marked $\frac{1}{4}$ S)

W oak 12 N 62° E 192 Links (6)
at 59.80 $\frac{1}{2}$ set $\frac{1}{8}$ temporary post 7 $\frac{7}{8}$ Links North and $\frac{1}{2}$ Links E
W oak (marked $\frac{1}{8}$ S) 19 in S 49° E 71 $\frac{1}{4}$ Links (7)

I hereby certify that the above is a true copy of original field notes
of above survey as made by Dep Surveyor Schroeder
Hilton, May 11, 1897.
Hamilton Le Rue
Co Surveyor

Variance 5° 15' E