


Sec 28-76.3<sup>h</sup> Surveyed and sub-divided, the 10<sup>th</sup> day of November 1899  
by F. A. Holden Dep. County Surveyor.

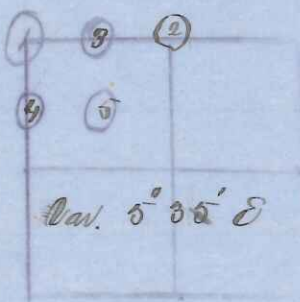

at (1) Section corner identified by old residents  
and states that how been kept

at (2) Corner identified by bar 20 N 8° E 174. Lying down  
Made new line N. 0 7 N 88° W 64. N. 0.6 W 35° W 46


at (3) Hurdery 6 N 50 E 78. N 0.6 N 16 W 74

at (4) f 0 12 E 57 Bar 0.6 W 27° E 37

at (5) f 0. 8 N 36 W 47. Bar bar 6 N 51 W 24

Recorded June 9<sup>th</sup> 1900. Hamilton La Rue  
Co Surveyor

Sec 28 217.4<sup>h</sup>. Surveyed and sub-divided Nov 16 1899 by F. A. Holden Dep  
County Surveyor.

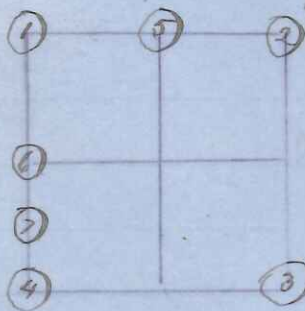

at (1) Sec Co identified f Pins 15 88° W 340. Other line gone

at (2) " " " f Pins 10 82° W 372 " " "

at (3) " " " by stone placed by former  
surveyor, while the trees were standing

at (4) identified by running from Town Line W

at (5) New Bearings f. 9 539° W 156. f 0.4 N 66° W 67

at (6) Made new Bearings Br 0.9 N 15 E 102 Br 0.4 534 E 48

at (7) Barwood 8 N 18 E 31. Br 0.4 534 E 48

Recorded June 9<sup>th</sup> 1900. Hamilton La Rue  
County Surveyor