


Sec 24 P15 2tr

Surveyed and subdivided Sec 24 in Town 10 Range 2tr and proceeded as follows: Commenced at the N E corner of the Section, the same being a known corner, at 40 chains running South identified 1/4 corner from old Bearing, ^a from 5 N 29 W 22 the other bearing could not be found, at 80 ch set temporary stake no bearings could be found. Returned to the place of beginning run West, at 40 chains set temporary stake, Bearings gone.

at 80 chains and 12 feet, found in new 18 feet north of corner of Sec 13, 14 23 + 24. Connected East, and made 1/4 post permanent. Returned to corner of 13 14 23 + 24 and south at 40 ch set temporary 1/4 post and at 80 chains struck corner of 23 24 25 + 26, it being a known corner. Thence East, at 40 chains set temporary 1/4 post and at 80 chains intersected our lines on Town line. Then run from the 1/4 post on the north to the 1/4 post on the south, also from the East 1/4 post to that on the West and at the intersection of these lines the center post was planted

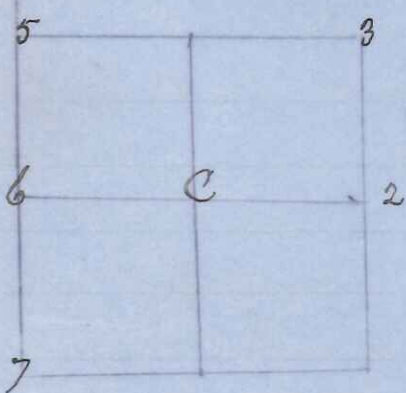

At 3, 5 and 7 new known corners
 at 2 corner established from old B
 at C Elm 7 S 26 E 178 feet
 Linden 12 N 18 W 3 feet
 at 6 W oak 3 in N 24 W 24 feet

mm 24