


Survey of Section 20. Town 16 R. 3 West

Commenced at 1/4 stake on South side of Sec 21 as shown by one witness line standing a B.O. 16 S 19° E 25 links the other B.O. 16 N 27° W 100 links. burned off & lying. Remaining land rounded variation of angle 4° 30' 40 chains and 38 Links, finally S.E. corner of Sec 20 with new witness line as indicated by plat no traces of old line left this remaining north for N.E. corner of Sec 20. no trace of old line left. Commenced at 1/4 post on West side of Sec 21 as indicated by one witness line standing a post 14 S 3° E 38 links. no trace of other line. running West 40 ch & 39 established corner of 16 17 20 & 21 with new line as per plat shown West 40 ch & 38 links established 1/4 post on North side of Sec 20 with new line as per plat. Established 1/4 post on East side Sec 20 with new line as per plat dividing distance between sec corners. Established 1/4 post on South side of Sec 20 40 chains West of Sec corner. New line as per plat. center post of Sec 1 & 17 stake made by dividing distance between corners. Done the 29 and 30 days of November and the 1st & 2nd days of December 1898

Paul A. Stodden
Sd of Surveyor

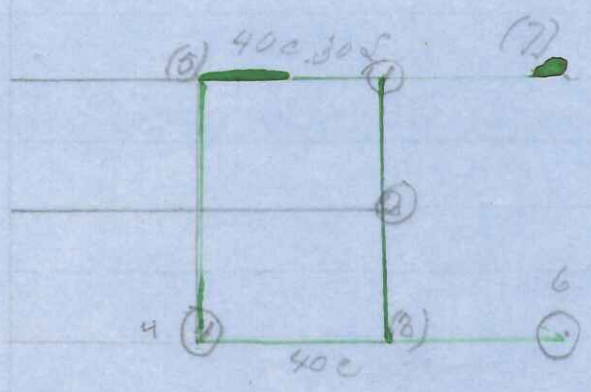

- Bearings
- (1) N. O. 16 N 8 20 W 23 Links
 - N. O. 11 S 34° 40' E 39 "
 - (2) J. O. 6 N 57° 50' W 40 "
 - J. O. 10 S 26° 50' W 60 "
 - (3) N. O. 10 N 13° 40' E 40 "
 - J. O. 12 N 57° 20' W 92 "
 - (4) J. O. 12 N 45° 30' E 120 "
 - J. O. 7 N 29° 30' W 14 1/2 "
 - (5) B. O. 18 N 38° 35' W 48 "
 - N. O. 12 S 67° 35' W 89 "
 - (6) B. O. 16 S 19° E 25 "
 - (7) J. O. 14 S 3° E 38 Links

Recorded this 29th day of December 1898
Hamilton La Rue
C. Surveyor