

State of Wisconsin

Monroe County 3<sup>rd</sup>


J. Fred A. Holden Dep't Co Surveyor in and for the County & State aforesaid, do hereby certify that I have surveyed and sub-divided Section 29, Tp 18 North of Range 4 West of Fourth principal Meridian, as represented by the corners and distances on the following plat and field notes of survey:

Declination of the Magnet from the true Meridian 5 1/2° E

Surveyed and sub-divided Apr 24 + 25<sup>th</sup> 1899, in accordance with the State Laws and Instructions of the Commissioners of the General Land Office

Witness my hand this 28<sup>th</sup> day of April 1899

Fred A. Holden Dep't Co Surveyor

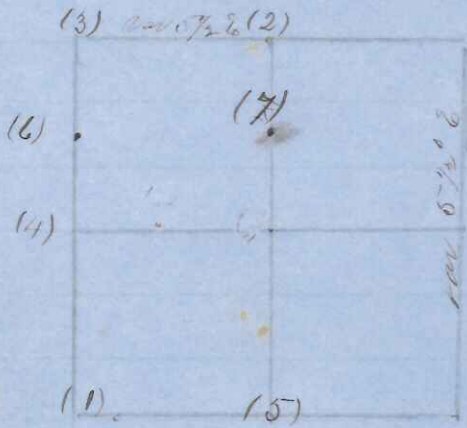

25 of (1) Original corner

" (2) Original true sounding B.O. 6 S 46° E. 32 L

" (3) Tr. O. 6 S 85° E 58 1/2

B.O. 8 N 28 1/2 E 62

" (4) B.O. 7 N 11° E 33

B.O. 6 S 5 1/2 E 49

" (5) Tr. O. N 64 1/2 W 17

B.O. N 10 1/2 E 27 1/2

" (6) B.O. 12 N 66 1/2 W 90

B.O. 8 N 8° E 154

" (7) Tr. O. 9 N 50° W 143

Tr. O. 10 N 29 1/2 W 140

Recorded this 1<sup>st</sup> day of June 22 1899

Hamilton La Rue

Co Surveyor