


Sec 30 5/18/99

State of Wisconsin
 Monroe County 3rd J. P. A. Holden Dep Co Surveyor in and for
 said Monroe Co Wis, do hereby certify that I have surveyed and set and divided
 Section 30. T418 N of R 4 West as represented by courses and distances on
 the following plat and annexed field notes of survey:
 Established center of Section at the point of intersection of straight
 quarter lines. Established all lot corners at proportional distances
 between known sections and quarter section corners according to the
 original field notes of Government survey
 Declination of Magnetic from the true Meridian $5^{\circ} 30' E$
 Surveyed and subdivided Apr 26, 27 + 28th A.D. 1899 in
 accordance with the State Laws and Instructions of the Commis-
 sioners of the General Land Office
 Witness my hand this 29th day of April A.D. 1899
 J. P. A. Holden Dep Co Surveyor

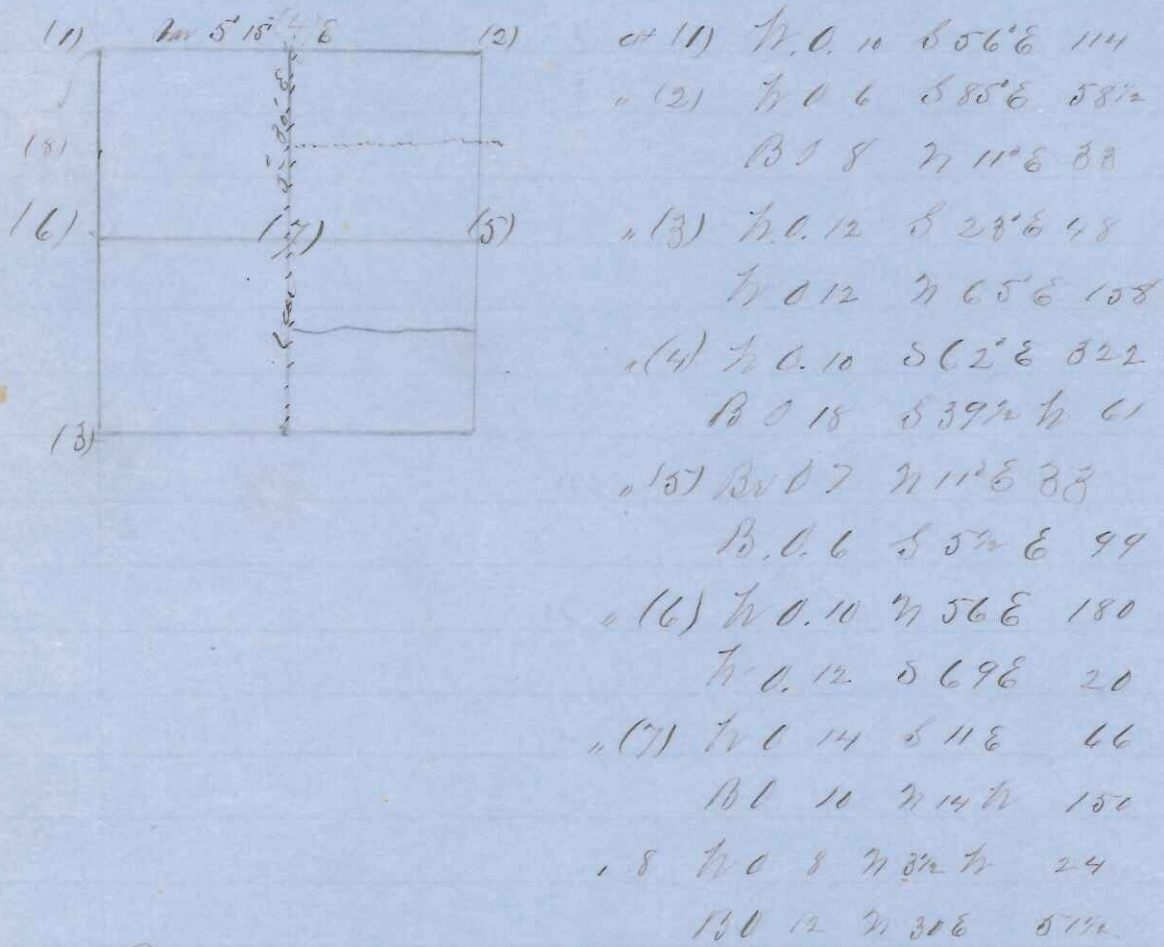

Recorded this 1st day of June A.D. 1899
 Hamilton La Rue
 Co Surveyor