


Sec 19 1/2 18 R 4th

State of Wisconsin  
 Monroe Co

J. Fred A. Holden Capt Co Surveyor in and for Monroe Co Wis. do hereby certify that I have surveyed and subdivided Sec 19 1/2 18 R 4th as represented by corners and distances on the following plat and field notes of survey

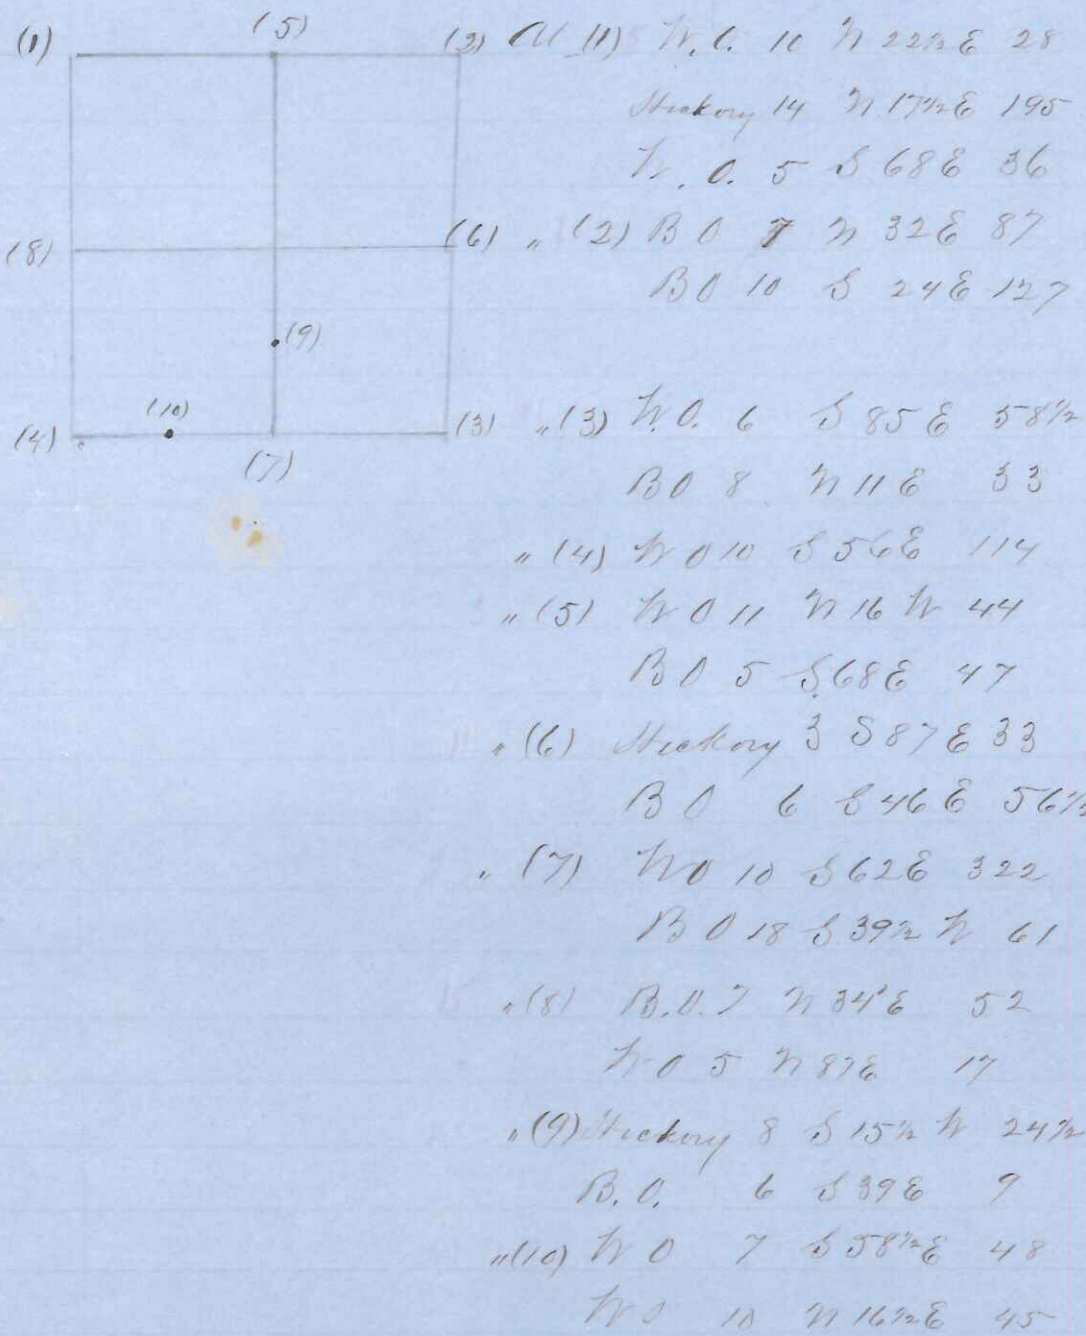

Recorded this 1st day of June A D 1899  
 Harrison La Rue  
 Co Surveyor