


Survey & Subdivisions of the South 1/2 Section 25 Township 16 North Range one West P Paul A Holden Surveyor in and for the County and State aforesaid do hereby certify that I have surveyed and subdivided the South 1/2 of the above named section as represented by the annexed plot & field notes of survey Established all quarter quarter corners upon the section boundary at proportional distances between known sections and quarter sections corners according to the original field notes of the Government survey Established all lost corners at proportionate distances according to original field notes of the Government survey declination of the magnetic Meridian from the true Meridian 5° 30' E Surveyed & subdivided April 9<sup>th</sup> 10<sup>th</sup> & 11<sup>th</sup> ad 1901 in accordance with the State laws and instructions of the Commissioner of the General Land office and recorded this 21<sup>st</sup> day of April ad 1901 Paul A Holden Co Surveyor

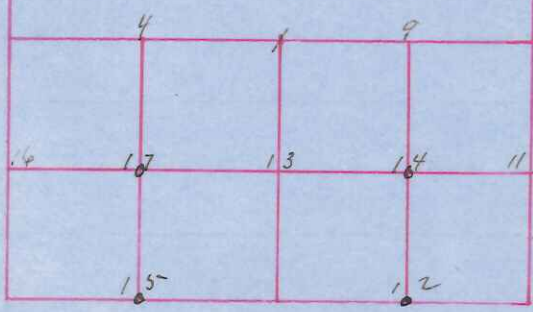

Field notes of above survey

SE Sec corner Established  
 T0 12 S 65° 20' 18"  
 T0 6 N 48° 20' 31"  
 SW Sec corner known corner  
 \* 12 R20 8 N 2 1/2 E 80 1/2  
 T0 6 S 79 1/2 W 38  
 \* 14 R20 5 S 75 W 46  
 T0 8 N 49 1/2 W 82  
 \* 15 R20 4 N 40 E 69  
 T0 6 S 43 E 3  
 " 17 T0 12 N 16 E 37

Survey assistants  
 Flagmen  
 Walter Arnett  
 Otto Arnett  
 Chaimers  
 Jm Lehman  
 S Lehman  
 F L Arnett