


Survey & Subdivision see 35 Township 15 North range 1 East of 4th principal meridian  
 State of Wisconsin }  
 County of Monroe } ss

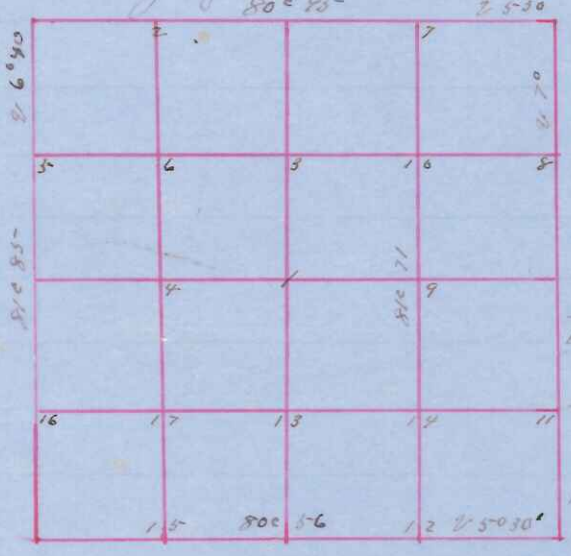

I Paul A. Holden Surveyor in and for the County & State aforesaid do here by certify that I have surveyed & subdivided the above named section as represented by the annexed plat & field notes of survey. Established the center of the section at the point of intersection of said quarter lines. Established all quarter corner upon the section boundary at proportional distances between known sections and quarter section corner according to the original field notes of the Government survey. Established all lost corner at proportional distances between known corner according to original field notes of the Government survey.

Declination of Magnetic from true Meridian 8° East  
 Surveyed & subdivided April 16<sup>th</sup> 17<sup>th</sup> & 18<sup>th</sup> ad 1901 in accordance with the State laws and instructions of the Commissioner of the General Land office and recorded this 23<sup>rd</sup> day of April ad 1901

Paul A. Holden - Surveyor

- Field notes of above named section
- |   |      |                           |
|---|------|---------------------------|
| NW Corner Original Bee Sugar 10 N 20 E 33 | # 6  | Maple 8 S 75 E 69         |
| Cherry 8 W 42 11                          | # 5  | Sugar 10 S 46 1/2 E 99    |
| NE " Hickory 6 S 40 E 56                  | # 7  | Pine Thimble South 37 1/2 |
| Placed by Lorus                           |      | Maple 4 N 21 1/2 W 88     |
| SE " Iron Bar at corner                   | # 9  | Maple 8 N 45 E 79 1/2     |
|   | # 9  | Pine Thimble at corner    |
| SW " Established by Venon Co Surveyor     | # 10 | Sugar 10 S 5 1/2 W 43     |
| Elm 6 N 67 1/2 W 48                       | # 12 | Sugar 14 West 66 1/2      |
| N 1/4 " Maple 10 N 72 1/2 E 23            |      | W 4 N 48 W 64             |
| Sugar 10 N 40 1/2 W 30                    | # 13 | Birch 3 N 33 E 62         |
| S 1/4 " Sugar 18 N 55 E 15                |      | W 5 S 59 E 28             |
| W 5 N 20 E 36                             | # 14 | Birch 4 N 47 W 20         |
| W 1/4 " W 6 S 3 W 16                      | # 14 | Elm 5 N 79 1/2 W 21       |
|   | # 15 | Birch 5 S 1 1/2 W 16 1/2  |
| # 1 - Iron bar at corner                  |      | Sugar 10 N 7 E 27         |
| 2 - Maple 12 N 68 W 84                    | # 16 | Sugar 10 S 65 E 42        |
| 3 - Pine Thimble South 37 1/2             | # 16 | Birch 10 N 2 1/2 E 33     |
| W 10 N 86 W 60                            | # 17 | Elm 10 N 77 E 46          |
| 4 - Sugar 6 N 27 E 46                     |      | Rail 06 N 2 1/2 W 32      |
|   |      | Sugar 10 N 70 1/2 E 53    |

Sworn Assistants

Chairman	Plaguer	Assess
Otto Schuell	Sant Rako	A. Wilson
M. M. Champlin	Paul Zinke	A. Pratt