


Sec 32 Town 15-R-3-W

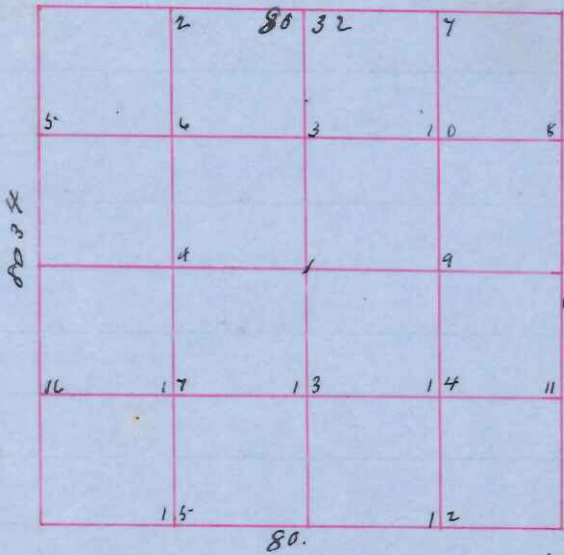

State of Wisconsin  
County of Monroe } SS

I Fred A. Holden Surveyor in and for County & State aforesaid Certify that I have surveyed and subdivided sec 32 Township 15 North range 3 West Established all lost corners at proportional distances according to Original field notes of the Govt Survey Established all 1/4's

Declination  
6°30' East

corners upon sec boundary at proportional distances between known sec and 1/4 section corners

done May 21<sup>st</sup> 27<sup>th</sup> 28<sup>th</sup> & 29<sup>th</sup> 1901

Field Notes

Original	NW Sec Corner	From Sleigh shoe at corner	200 12 N 28 E 73
	NE "	" Bar	70 8 S 80 1/2 W 194
	SE "	Stake set for distance	
Original	SW "	by Stone at corner placed when B run were standing	
	N 1/4 "		70 10 N 32 E 73
			200 14 S 61 20 115
From Pipe	E 1/4 "		70 8 S 16 W 47
			200 10 N 7 1/2 W 63
			200 16 S 4 W 77
	S 1/4 "		70 20 N 88 W 584
			200 18 S 2 1/2 W 114 1/2
From Pipe	W 1/4 "		70 16 S 58 1/2 E 120

Subdivision Corners

From at Cor #1	70 18 S 61 W 114 Stake South 37 1/2
	70 14 N 46 E 64 1/2
" 2	From Pipe West 37 1/2
" 3	From Pipe West 37 1/2
	200 24 N 65 W 74
" 4	Maple 8 N 40 1/2 E 81
" 5	
" 6	
" 7	Stake south 21
" 8	
" 9	From at corner
" 10	200 7 N 73 E 3 1/2
" 11	From pipe at corner
" 12	
	200 16 N 57 W 21
" 13	200 14 S 62 W 30
" 14	From Sleigh shoe at corner
	70 4 N 33 1/2 W 46
" 15	200 4 N 6 W 25
" 16	From Stake at corner
" 17	" " " "

Sworn Assistants  
Chairman  
Richard Bierig  
Arthur "  
George Von Rueden  
Flagman  
Henry Larson  
Coburn Squires  
Polvermacher

Witness my hand this 31<sup>st</sup> day of May ad 1901  
Fred A. Holden  
Co Surveyor