


Section 25 - Town 19
Range one west

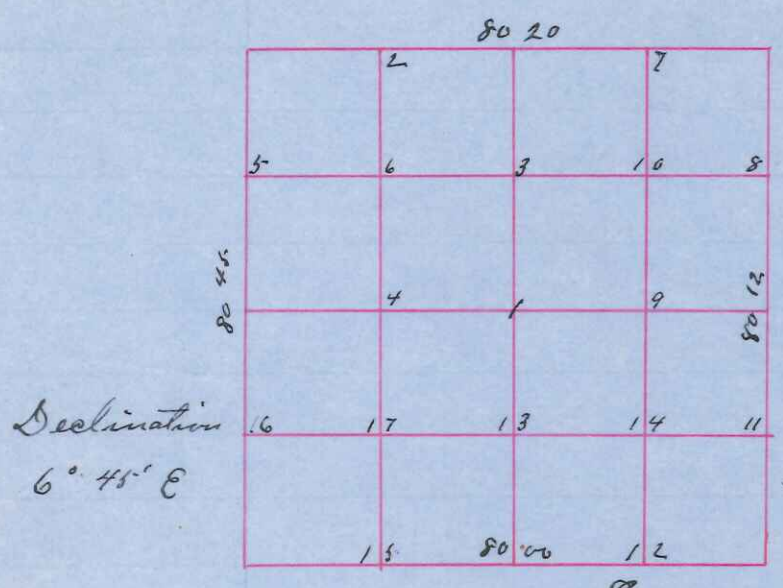

State of Wisconsin
County of Monroe JSS
I Fred A. Holder Surveyor in
and for County & State aforesaid
Certify that I have surveyed and subdivided
Section 25 - Town 19 range 1 west in accor-
dance with State Laws and Original
Field notes of Gout Survey
done June 26th 27th 28th + 29th ad 1901

Field Notes

- Original NW sec cor 20 8 S 50 1/2 E 186 From Plow shoe at corner
- Original NE " " W Pine 20 S 8 1/2 W 31 placed from thimble at corner
- SE " " Stake west 50
- SW " " 20 10 S 12 W 24
- N 1/4 " " 20 14 N 27 E 15-4 From pipe
- W 1/4 " " W P Stump 36 N 55 E 62
- E 1/4 " " " " 36 N 21 W 44
- S 1/4 " " Iron bar at corner
- W 1/4 " " 20 8 N 39 1/2 E 13
- SW 1/4 " " Iron bar west 37 1/2

Subdivision Corner

Sworn Assistants
Chairman

- | | | |
|------|---------------------|-----------------|
| #1 | Stake at corner | Thomas Nelson |
| " 2 | " " | Martin Peterson |
| " 3 | " " | Flagman |
| " 4 | " " | Nels Anderson |
| " 5 | " " | Henry " |
| " 6 | " " | Robt Peterson |
| " 7 | Plow shoe at corner | Alfred Anderson |
| " 8 | Stake at " | Arman |
| " 9 | " " " | Edw Brower |
| " 10 | " " " | |
| " 11 | Iron west 50 | |
| " 12 | Stake at corner | |
| " 13 | " " " | |
| " 14 | " " " | |
| " 15 | " " " | |
| " 16 | " " " | |
| " 17 | " " " | |

Witness my hand this 29th day of June 1901
Fred A. Holder
As Surveyor