


Sec 4 Town 19
Range 2 West

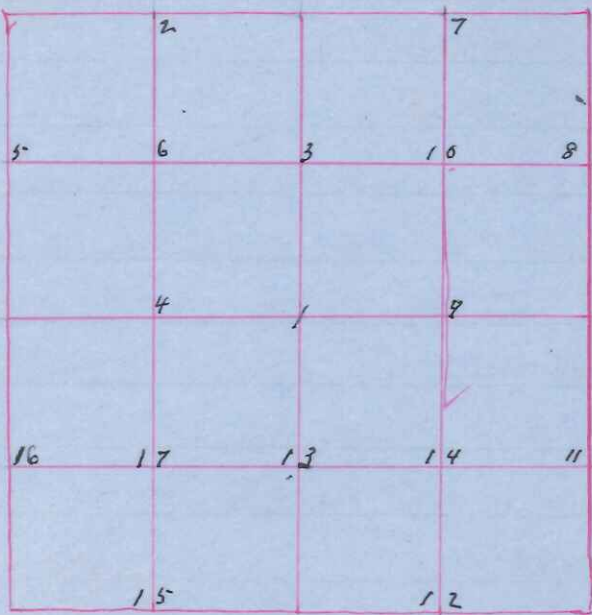

Declination
5° 30' E

State of Wisconsin
County of Monroe J.S.S.
I Fred A. Holders Surveyor in
and County and State aforesaid do
certify that I have surveyed and sub-
divided Section 4 Township 19 North
Range 2 West in accordance with State
laws and the field notes of Original
Survey
done Oct 10th + 11th ad 1901

Field Notes

Original NW sec corner X S on natural red sandstone ledge
NE " " Pin 4 SE 9
SE " " Pin 18 N 12 W 110 other tree gone
SW " " Iron bar at corner
N 1/4 " " ~~Stake at corner~~ Iron bar at corner
E 1/4 " " ~~Stake at corner~~ Iron bar at corner
S 1/4 " " Stake at corner
W 1/4 " " Stone at corner witness Stone N 54 E 57

Subdivision Corners

# 1	Stake at corner	
# 2	" "	Sworn assistants
" 3	" "	Chairman
" 4	" "	S. B. Ganetron
" 5	" "	Ren Van Vorhes
" 6	" "	Flagmen
" 7	" "	J. P. Floyd
" 8	Iron bar "	John Stuedewant
" 9	Stake at "	Atmen
" 10	" "	W. Stuedewant
" 11	Iron bar "	Carl Gebhart
" 12	" "	
" 13	Stake at corner	
" 14	" " "	
" 15	" "	
" 16	" "	
" 17	" "	

Witness my hand this 20th day of December ad 1901
Fred A. Holders
Co Surveyor