


N 1/2 of section 26
 Town 19 one west

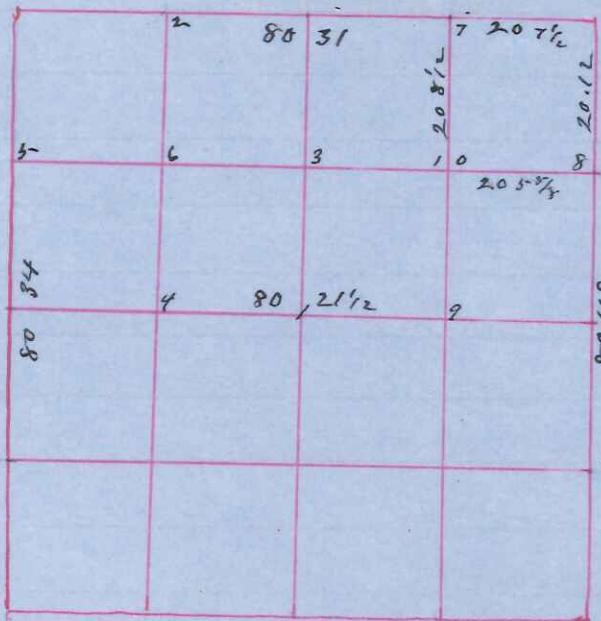

Declination
 8° 30'

State of Wisconsin
 County of Monroe J.S.B

I Paul A. Holden Surveyor in
 and for County & State of Wisconsin
 Certify that I have surveyed and
 subdivided the north 1/2 of section
 26 township 19 range one west in
 accordance with state laws and
 field notes of Original Govt Survey
 done from 20th to 21st ad 1901

Original	NW Sec corner	From bar at corner
NE	" "	" Plow share "
SE	" "	200 10 S 12 W 24 200 14 N 27 E 15 1/2 From pipe at corner
SW	" "	" "
N 1/4	" "	70 7 N 14 E 30 1/2 70 6 S 4 W 14
E 1/4	" "	From bar west 37 1/2
S 1/4	" "	From at corner
W 1/4	" "	From at corner

Subdivision	Corner	Sworn assistants
# 1	Spruce Stake W.P. Stake 24 N 24 E 38 1/2	Chairman N 71 W 49
" 2	From Gun barrel at corner	P. L. Pederson
" 3	" "	Andrew Wisby
" 4	" "	Flagman
" 5	Stake at corner	A. Sorenson
" 6	From batt at corner W.P.C. N 67 W 44	Carl Larson
" 7	" Stake N 55 E 53 1/2	
" 8	Stake at corner	
" 9	200 4 S 60.30 E 30 1/2 70 6 N 22 E 107 1/2	
" 10	Stake at corner	

Witness my hand this 20 day of January ad 1901
 Paul A. Holden
 Co Surveyor