


Sec 24 Town 19
R 1 - West

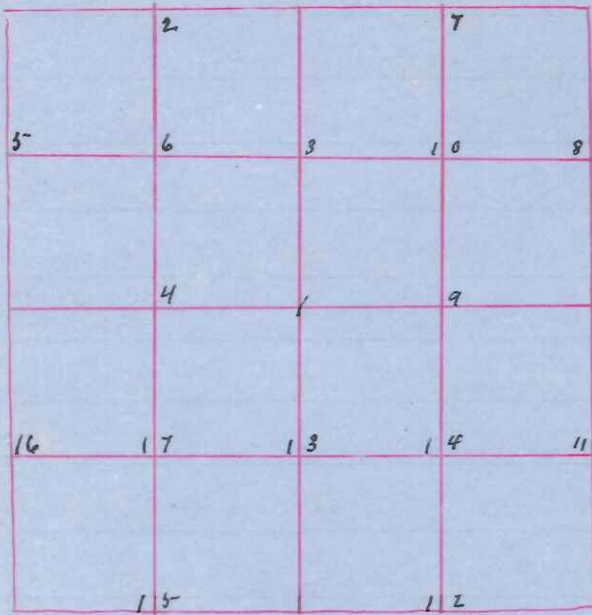

Decl
5° 30' East

State of Wisconsin
County of Monroe JSS
I Paul A Holden Surveyor in
and County and State aforesaid
certify that I have surveyed and sub-
divided Section 24 Township 19
Range one West according to State
Law and the field notes of Original
Govt Survey
done Jan 3rd 5th 6th 7th ad 1902

- Field notes
- Re-estab NW Sec Corner fo 6 554.20 W 122
 - NE " " fo 5 567 W 113
 - Original SE " " Iron Thimble at Corner
 - SW " " Plow share at " "
 - Iron bar NW 1/4 " " fo 6 N 30 E 122
 - mental E 1/4 " " W.P. Stump N 70 2/3 E 22 ft
 - S 1/4 " " W.P. Stump N 50 45 E 54 ft
 - W 1/4 " " W.P. " 36 N 55 E 62 ft
 - " " " " 36 N 21 W 44
 - " " " " 1/4 Iron Pipe East 37 1/2

- | Subdivision | Corner | Sworn assistants |
|-------------|---|------------------|
| * 1 | Plow share at corner
fo 5 N 36 W 89 | Chairman |
| " 2 | Stake at corner
W Pine 10 N 58 30 W 36 | P. C. Pederson |
| " 3 | " " " 6 N 36 15 E 10 | Anders Wisby |
| " 4 | Iron Rod at corner
W.P. Stump East 35- | Flagmen |
| " 5 | Plow share at corner
W Pine 36 N 41 E 24 1/2 | C. Larson |
| " 6 | | Martin Sorenson |
| " 7 | 1/2 Iron at corner
W Pine 14 N 65 E 38 ft | Arner |
| " 8 | fo 3 N 49 E 17 | Soren Wisby |
| " 9 | W Pine 18 North 52 | B. Jensen |
| " 10 | Plow share at corner | |
| " 11 | | |
| " 12 | | |
| " 13 | 3/4 Iron Rod 3 ft long
W Pine Stump N 45 30 W 20 | |
| " 14 | | |
| " 15 | Stake at corner | |
| " 16 | Iron casting West 37 1/2 | |
| " 17 | | |

Witness my hand this 20th day of Jan ad 1902
Paul A Holden
Co Surveyor