


Sec 23 Town 19
Range 1 West

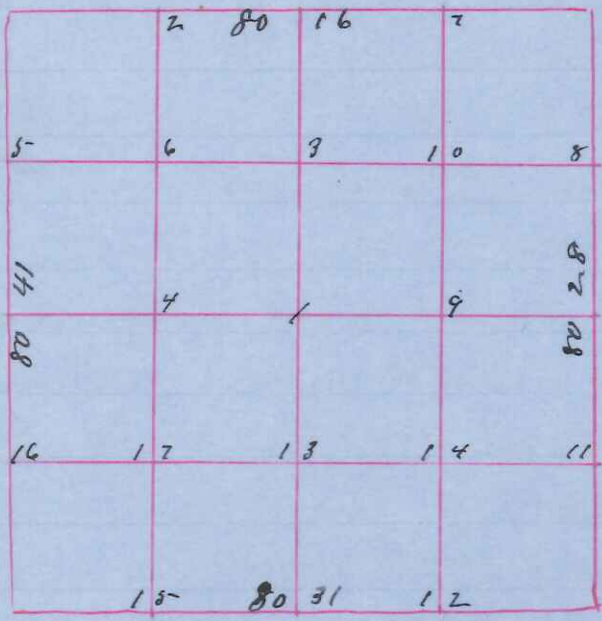

Sec 50 30'E

State of Wisconsin
County of Monroe) SS
I Paul A Holder Surveyor in
and for County and State aforesaid
Certify that I have surveyed
and subdivided section 23
Township 19 range one west
according to State laws and the
field notes of original field notes
of Govt survey
done Jan 2nd 8th 6th 7-8-9 ad 1902.

Field notes

- NW sec corner 1 1/2 in Pipe at corner WP Stump 28 N 50° 30' E 19
- NE " " from Pipe at corner fo 6 S 55 W 122 fo 5 S 66 W 113
- SE " " Plow share at corner
- SW " " Iron bar " "
- N 1/4 " " Plow share " "
- N 1/4 " " WP Stump 30 East 19
- E 1/4 " " 1 1/4 Pipe East 37 1/2 fo 7 N 14 E 30 1/2
- S 1/4 " " fo 6 S 4 W 14 fo 6 N 31 E 120
- W 1/4 " " fo 4 S 80 1/2 E 171

Sworn assistants

- Chairmen
P O Pederson
Andrew Jensen
Carl Larson
- Adjudgers
L Larson
Nels Jensen
N Morrison
- Witness
Paul Jensen
Nels Morrison

Subdivisions

- from pipe # 1 fo 7 S 5 1/2 E 94 Elms 6 S 80 1/2 W 239 Stake at corner
- " 2 ~~Plow share at corner~~
- " 3 Plow share " "
- " 4 Casting " "
- " 5 fo 4 S 75 W 10
- " 6 2 1/2 in Iron at corner
- " 7 1 in Pipe " "
- " 8 Plow share " "
- " 8 WP Stump 36 N 4 E 24 1/2
- " 9 " 24 West 7
- " 10 Iron pins at corner
- " 11 Casting West 37 1/2 WP line 6 N 67 W 44
- " 12 " 57 1/2 N 55 E 53 1/2
- " 13 Iron pipe at corner
- " 14 1 1/4 Pipe Elbow on top
- " 15 Iron at corner
- " 16 " " " "
- " 16 WP Pine 10 N 59 1/2 E 52
- " 17 fo 6 S 20 E 2 1/2

Witness my hand this 20th day of Jan ad 1902
Paul A Holder
Co Surveyor