


Sec 9 Town 19  
Range 2 West

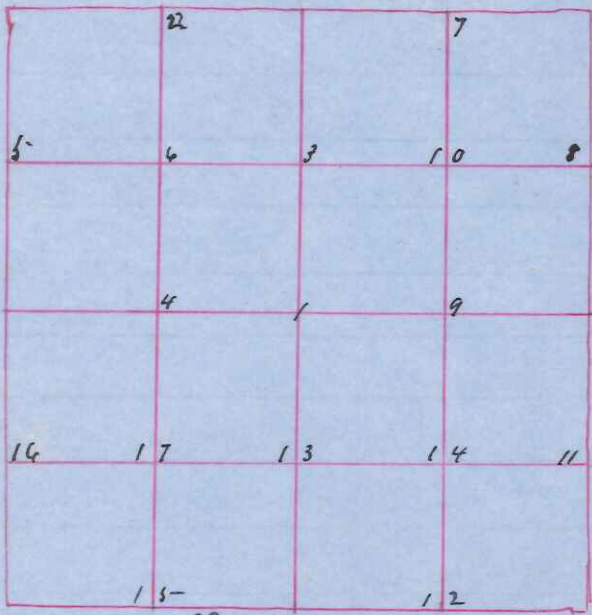

State of Wisconsin  
County of Monroe J.B.B.  
I Paul A Holden Surveyor in and  
for County and State aforesaid  
Certify that I have surveyed and  
subdivided section 9 Township 19  
range 2 west in accordance with  
State laws and the Field notes of  
Original Govt Survey  
done Oct 4<sup>th</sup> & 5<sup>th</sup> Oct 1901

Sec 5°30'E

Field Notes

Reclab	NW Section Corner	Stone at Corner + Mks
"	NE "	" Iron Bar "
"	SE "	" "
Stone at Cor	SW "	" "
"	N <sup>1</sup> / <sub>4</sub> "	" "
"	E <sup>1</sup> / <sub>4</sub> "	" "
"	S <sup>1</sup> / <sub>4</sub> "	" Stone at Corner "
"	W <sup>1</sup> / <sub>4</sub> "	" " " "

Iron Bar  
Fo 6 S 40 20 87  
Fo 6 N 39 1/2 20 89  
Fo 10 S 40 20 148  
Fo 8 S 48 20 164

Subdivisions

- # 1
- " 2
- " 3
- " 4
- " 5
- " 6
- " 7
- " 8
- " 9
- " 10
- " 11
- " 12
- " 13
- " 14
- " 15
- " 16
- " 17

Savon Assistants

- Chairmen
- S B Santow
- E B Parke
- Flagmen
- Stone at Corner
- G W Mines
- Ora Martin
- Carl Gebhart
- Atomers
- Samuel Shookman
- Hiram Hall

Witness my hand this 25<sup>th</sup> day of Jan 1902  
Paul A Holden  
Co Surveyor