


West 1/2 of
 Section 16 Town 19
 Range 2 West

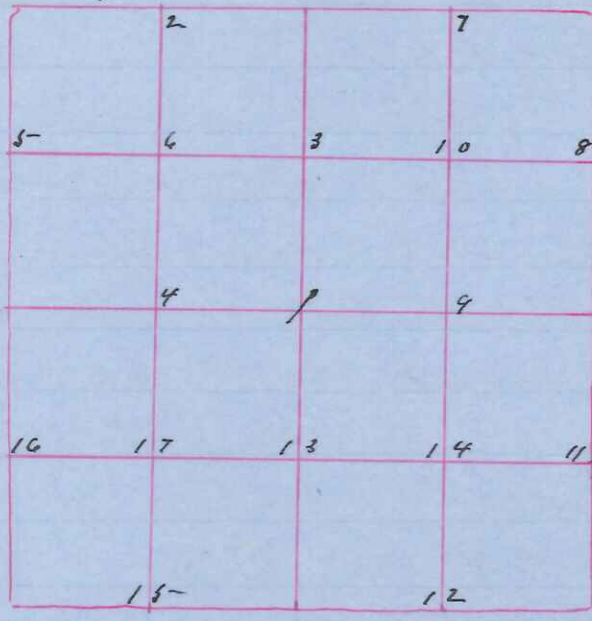

Dec 5° 30' E

State of Wisconsin
 County of Monroe 588
 I Paul A Holden Surveyor in
 and for County & State of record
 Certify that I have surveyed & sub
 divided the West 1/2 of section 16
 Township 19 Range 2 West in ac
 cordance with State laws and
 Field notes of Original Govt Survey
 done Oct 9th ad 1901

Field Notes

- NW Section Corner fo 10 S 40 W 148
- NE " " fo 8 S 48 W 164 Stone at corner
- SE " " fo 6 S 40 W 87
- SW " " fo 6 N 39 1/2 W 89
- N 1/4 " " Stake at corner
- E 1/4 " " Stone " "
- S 1/4 " " No 12 S 80 W 47
- W 1/4 " " of pins 10 S 71 E 19
- fo " 10 N 46 1/2 E 21

Subdivisions

- # 1 Sworn assistants
- " 2 Chairmen
- " 3 Stake at corner G B Ganstrom
- " 4 E B Parker
- " 5 " " " Flagmen
- " 6 W E Martin
- " 7 Ora " "
- " 8 E W Smith
- " 9 Alexmer
- " 10 J P Hloyd
- " 11
- " 12
- " 13 " " "
- " 14
- " 15 " " "
- " 16 " " "
- " 17

Witness my hand this 27th day of Jan 1902
 Paul A Holden
 Co Surveyor