


N East 1/2 of
 Sec 20 Town 19
 Range 2 West

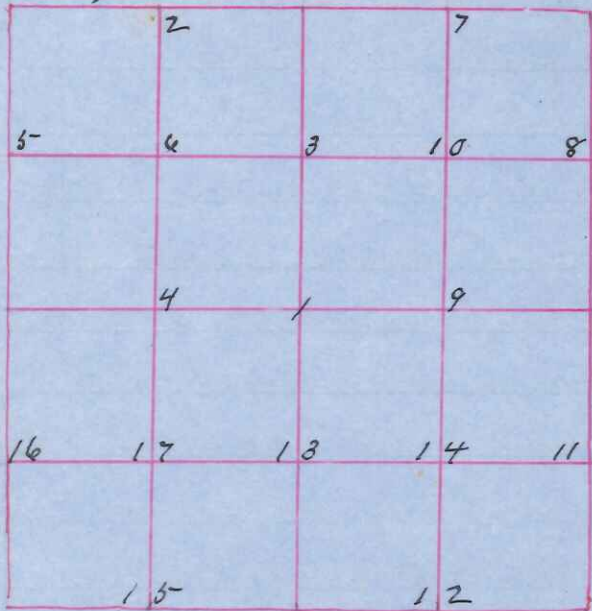

Sec 6° East

State of Wisconsin
 County of Monroe J.S.S
 I Fred A. Holden Surveyor in and
 for County and State of Wisconsin certify
 that I have surveyed and subdivided
 Section 20 Town 19 Range 2 West in
 accordance with State laws and the
 Field notes of the Original Govt Survey
 done Oct 16th + 17th ad 1901

Field notes

- NW Section Corner 20 10 S 63 E 87
- NE " " Stake at corner
- SE " " 20 10 N 79 E 87
- SW " " 20 12 N 55 W 56
- N 1/4 " " 20 8 N 58 E 90
- E 1/4 " " 20 6 N 29 W 58
- SW 1/4 " " 20 6 S 11 W 86
- Stake at corner

Subdivision

- # 1 20 8 N 61 E 229
- " 2 Stake at corner 20 7 N 82 W 50
- " 3 20 8 N 28 1/2 E 304
- Stake at Cor " 4 20 7 N 58 1/2 E 542
- " 5- 20 6 N 28 W 27
- " 6 20 6 N 28 W 27
- " 7
- " 8
- " 9
- " 10
- " 11
- " 12
- " 13 W Pine 16 N 42 1/2 W 304
- " 14 20 7 S 46 W 102
- " 15- 20 7 N 32 E 121
- " 16
- " 17 Iron Bar West 37 1/2

Sworn assistants

- Chairmen
- David Hedling
- Ed Briggs
- Flagmen
- J. S. Dutton
- Will Hetrick
- Examers
- Grant Wood
- J. D. Wood

Witness my hand this 3rd day of Feb ad 1902
 Fred A. Holden
 Co Surveyor