


Sec 30 Town 19
Range 2 West

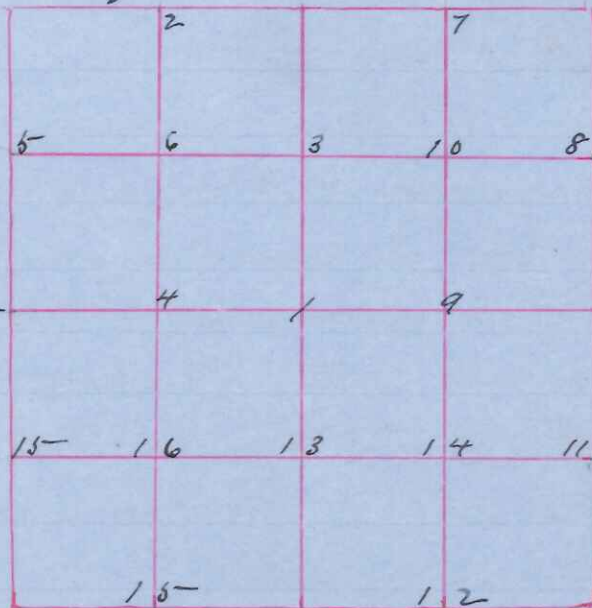

Dec 6° East

State of Wisconsin
County of Monroe J.S.B
I Paul A Holder Surveyor in and for
County & State aforesaid certify that
I have surveyed and subdivided
section 30 township 19 range 2 west
in accordance with State laws and
Field notes of Original Survey
done
Oct 14th 17th 18th + 19th ad 1901

Field Notes

	N & Section corner	fo 7 S 17 E 81
	NE "	fo 6 N 39 W 19
	SE "	fo 12 N 55 W 56
Original	SW "	fo 8 N 58 E 90 B 0 10 N 74 W 192
	N 1/4 "	fo Pin 10 S 27 E 185 Pin 6 S 18 1/2 E 22 1/2
	E 1/4 "	" 8 S 65 E 22
	S 1/4 "	1 1/2 in Iron pipe at corner B 0 5 N 52 1/2 E 187
	W 1/4 "	B 0 4 N 84 E 76
		1 1/2 in Pipe East 37 1/2 fo 7 S 61 1/2 E 97
		fo 7 S 62 W 70

Subdivisions

	# 1	fo Pin 10 N 60 1/2 W 47
	" 2	fo Pins 10 S 60 E 81 fo 6 S 77 W 69
Iron pipe	" 3	fo Pins 14 S 65 E 66
	" 4	Iron Pipe N 37 1/2
	" 5	fo 8 N 25 E 43 fo 8 N 19 1/2 E 142 fo 8 N 0 24 6-3
Iron at Cor	" 6	fo 7 N 75 W 60
	" 7	fo
	" 8	Iron Pipe South 37 1/2 fo Pins 12 N 25 E 43
	" 9	B 0 0
	" 10	B 0 6 N 68 E 181
	" 11	Iron Thimble at corner
	" 12	
	" 13	Iron pipe East 37 1/2
	" 14	" Thimble at corner W Pin 30 S 28 W 2
	" 15-	" " 22 N 39 W 67
	" 16	" " 24 N 33 E 335-
	" 17	fo Pins 8 S 65 E 292
	" 17	Cast Iron Thimble at corner

Sworn assistants

- Chairmen
David Hedling
Ed Brigg
- Flagmen
J S Dutton
Will Ketrick
- Armen
Grant Wood
J D Wood

Witness My hand this 3rd of Feb 1902
Paul A Holder
Co Surveyor