


Sec 11 town 15-  
Range 1 west

Sec 6° E

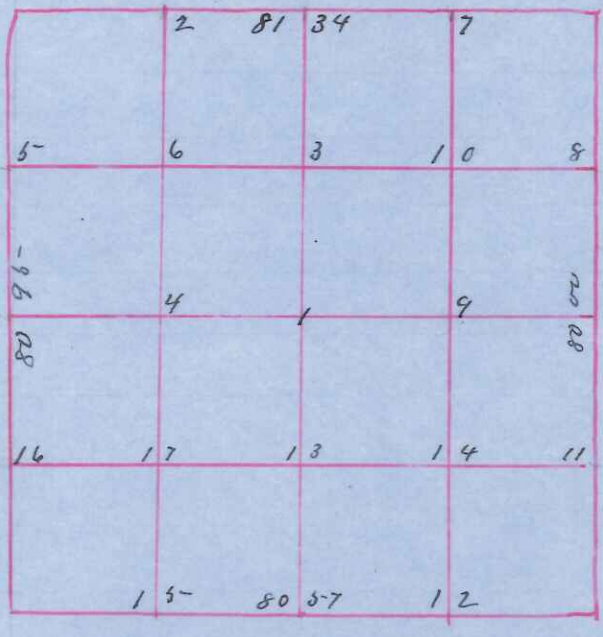

State of Wisconsin  
County of Monroe  
I Paul A Holder Surveyor in and  
for county and State aforesaid certify  
that I have surveyed and subdivided  
sections 11 Township 15-Range one west  
in accordance with state laws and  
the field notes of Original Govt Survey  
done Nov 21<sup>st</sup>, 22<sup>nd</sup>, 23<sup>rd</sup> & 25<sup>th</sup> ad 1901

Field notes

Iron Bar	NW Section Corner	Red 14 N 22 E 24 1/2
"	NE "	Elm 10 N 7 E 24
"	" "	Wo 10 S 81 E 16
Original	SE "	Red 8 N 79 1/2 W 58 1/2
Original	SW "	" 7 N 66 W 28
Iron pipe	N 1/4 "	Elm 5 S 64 E 29
" Bar	E 1/4 "	at the tree gone
" "	S 1/4 "	Wo (Wash) 12 S 42 W 75-
" "	W 1/4 "	Wo 14 N 11 E 119 1/2
" "	" "	Red 0 7 S 38 W 18
" "	" "	Red 0 7 S 73 E 7
" "	" "	Wo 10 S 82 E 87
" "	" "	Maple 8 S 29 E 13 1/2
" "	" "	Red 0 8 S 59 E 21 1/2
" "	" "	Wo 5 N 6 1/2 E 29 1/2

Subdivision corners

# 1	3 in Iron at corner	Wo 12 N 60 W 99
" 2	Maple 12 S 76 W 29	
" 3		
" 4		
" 5	Elm 5 S 76 E 21	
" 6		
" 7	Red 0 10 S 77 W 36 1/2	
" 8	Hickory 4 S 19 W 35-	
" 9	Red 0 5 N 75 W 2	
" 10	Iron bar at corner	
" 11	Stake at corner	
" 12	Wo 10 N 10 E 27	
" 13	Wo 10 S 20 E 9	
" 13	Iron Rod at corner	

Sworn assistants

Chairmen
Joseph Colman
W Sherburn
Herman Popp
Magnum
A S Grant
John O'Rourke
Herman Popp
Atmrs
S Grant
Chris Hymen

Witness my hand March 10<sup>th</sup> 1902  
Paul A Holder  
Co Surveyor