


Section 30 town 18
Range one west

Dir 5° 30' E

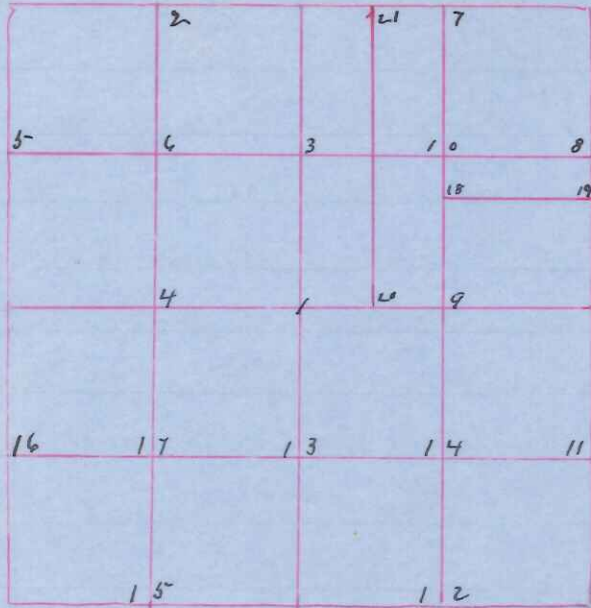

State of Wisconsin
County of Monroe T.S.S.
I Paul A. Holden Surveyor in and
for County & State aforesaid do hereby
certify that on petition of Majority of
the Land Owners of section 30 Township
18 range one west I have surveyed and
Subdivided said section in accordance
with the Terms of section 827a Statutes
1898 Laws of 1901

done Jan 14, 15, 16, 17, 18th ad 1901

Field Notes

Stake at Corner	Section	Corner	Notes
6x6x30xmk	NW	Section Corner	fo 12 N 23 E 124 fo 8 N 43 E 20
"	NE	"	Dir 200 7 N 39 W 37 20 12 N 42 1/2 W 131
"	SE	"	fo 12 S 4 W 240 fo 14 N 56 1/4 W 225
"	SW	"	fo 8 N 18 W 245 fo 16 S 24 E 24
"	N 1/4	"	fo 14 S 57 E 31 fo 12 S 86 E 95
"	E 1/4	"	"
"	S 1/4	"	Maple 14 S 84 E 2 1/2 fo 12 N 89 W 66 fo 14 N 34 W 26
"	W 1/4	"	20 8 S 50 E 27

Subdivision Corners

1	Bo 20 S 85 E 81
2	"
3	"
4	Bo 16 S 74 1/2 W 13
7	Farmers Stake at Corner Bo 1
9	Cherry 18 N 59 1/2 E 16 1/2 fo 8 S 70 E 69
11	fo 7 N 15 1/2 E 64 fo 6 S 67 W 32
12	fo 14 S 25 E 55 1/2
14	Iron bolt
15	fo 6 S 10 W 13
17	Dray tooth at corner
18	" " "
19	1 1/8 in Iron bar "
20	1 " " "
21	Angle Pavers

Sworn Assistants

Chairmen
D E Hubbell
D O Ragan
E Shuttler
Flagnier
Sam Nesson
Peter "
John Boynton
John Bill
Attorneys
Gust Krasse
Peter Nesson
Hans Rasmussen

Witness my hand this 20th of Feb ad 1902
Paul A. Holden
Co Surveyor