


Sec 27 Town 15-
Range 1 West

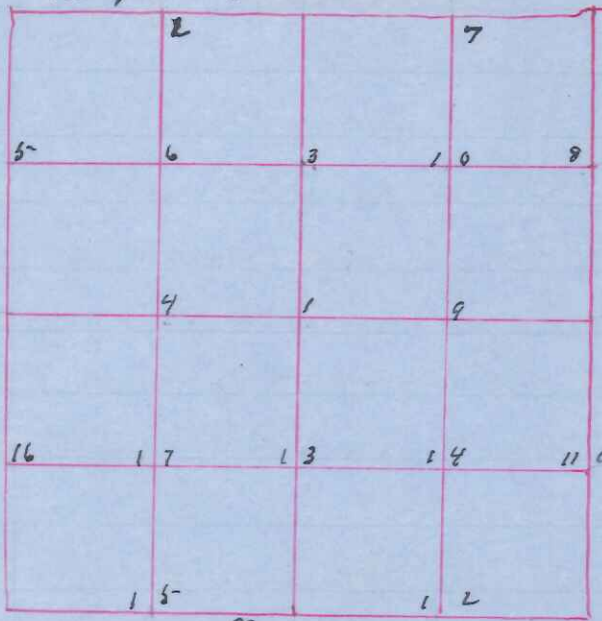

State of Wisconsin
 County of Monroe JSS
 I Paul A Holden Surveyor in and
 for County and State aforesaid certify
 that I have surveyed and subdivided
 Sec 27 Town 15- range one West in ac-
 cordance with State laws and the Field
 Notes of Original Govt Survey
 done Nov. 30th, 31st Dec 2nd 3rd 4th 5th ad 1901

Dec 5th 45th

Field Notes

Original from bar	Subdivisions	Notes
1 x 1 3/8 x 18	NW Section Corner	Sugar 12 S 91 E 32
2 in bar	NE	W. Ash. 11 S 27 1/2 W 29 Hickory 8 44 E 18
Original	SE	Red 0 4 S 52 1/2 W 43 Sugar 10 N 20 E 33
	SW	Other tree gone W 0 8 N 88 E 101
	N 1/4	Red 0 5 N 82 1/2 W 48 W 0 12 N 78 E 29 1/2
	E 1/4	Wash 5 S 18 W 35- Sugar 7 N 83 W 31 1/2
Original	S 1/4	" 4 N 42 1/2 E 23 W 0 24 N 20 W 3
	W 1/4	Other tree gone Maple 14 N 41 1/2 E 12 " 12 S 53 1/2 E 40

Subdivisions corners

# 1	Ironwood 5- N 16 1/2 W 23 1/2 Ash 4 S 6 W
" 2	
" 3	Stone at corner x mk W 0 6 N 21 E 34 1/2
" 4	Red 0 7 N 38 W 35-
" 5-	
" 6	
" 7	
" 8	
" 9	Red 0 10 N 45-20 3 " 10 N 13 E 101
Iron bar	" 10 Maple 12 S 46 E 61

Sworn Assistants

- Chairman
 A W Junker
 August Zuelke
 Fred Junker
 J Zinke
 George Junker
 Attest
 August Blais
 E Purpore

Witness my hand this 19th day of Feb ad 1902
 Paul A Holden
 Co Surveyor