


NW 1/4
 Section 27 town 17
 range 3 west

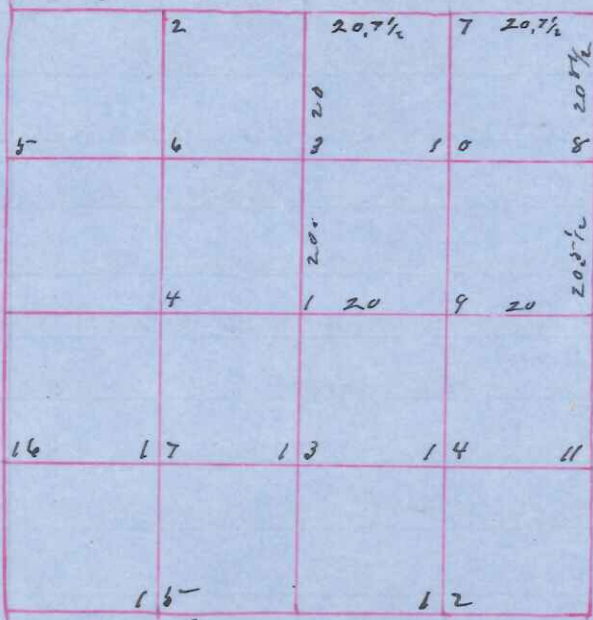

State of Wisconsin
 County of Monroe J.B.S.
 I Paul A. Holder Surveyor in and
 for County and State aforesaid certify
 that I have surveyed and subdivided
 the NW 1/4 of Section 27 Town 17 Range
 3 West in accordance with State
 Laws and the Field notes of Original
 Supt. Survey
 done April 2nd and 3rd ad 1902

Dec 5° E

Field Notes

- Original NW Section corner No 10 N 8 E 27 ^{marked} 3 in Iron Pipe at corner
- Original NW 1/4 " " 3 in Iron Pipe at corner
- Original NW 1/4 " " Stake at corner
- Subdivision " "
- # 1 No 12 N 62 E 192
- # 2 Jo 6 S 80 W 25 1/2 ft
- # 3 3 in Iron pipe
- " 4 Stake at corner
- " 5 No 12 N 84 E 46 ft
- " 6 3 in Iron pipe

Sworn assistants
 Chalmers
 Patterson
 Fredericks
 Flayman
 W.P. Buckley
 R.F. Whole

Witness my hand this 8th day of April ad 1902
 Paul A. Holder
 Co Surveyor