


a part of Section 29
Town 17 Range 3 West

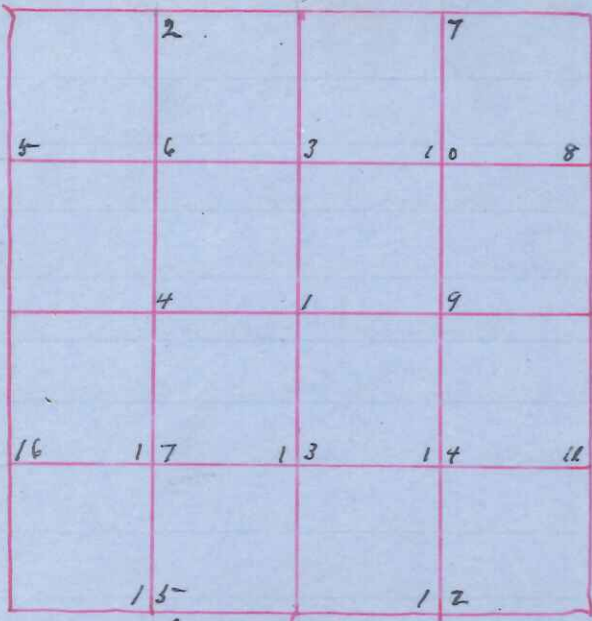

Sec 5° 30' E

State of Wisconsin
 County of Monroe } ss
 I Fred A. Holden Surveyor in and
 for County and State aforesaid certify
 that I have surveyed a part of Sec 29
 Township 17 Range 3 West in accordance
 with State laws and the field notes of
 Original Govt Survey
 done April 4th ad 1902

Field Notes

- Original S E Section corner Pines 9 S 88 E 238 (New) & Pine 10 S 19 1/2 W 8
- " S W " " Iron rod at corner
- " S 1/4 " " Br 0 10 N 5 W 228
- " " " Br 0 8 321 3/4 in rod at corner

Subdiv Cor
 # 15 to 10 N 21 1/2 E 82
 # 14 N 57 W 28

Sworn assistants

Chairmen

Henry Alger

J A Paul

Flagmen

Fred Leak

San C Smith

Witness my hand this 28th day of April ad 1902

Fred A. Holden

Co Surveyor