


N 1/2 of Sec 13 Town 19
Range 2 West

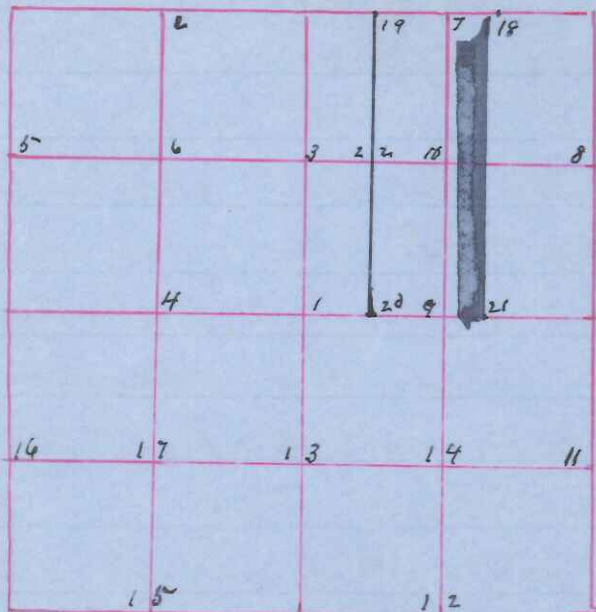

Dec 5° E

Field notes

State of Wisconsin
County of Monroe J. H.
I Fred A. Holden Surveyor in and
County and State aforesaid certify
that I have surveyed and subdivided
the N 1/2 of sections 13 Town 19 range 2 west
Stone in accordance with State Law
and field notes of Original Govt Survey
April 15th 16th & 17th ad 1902

Original	NW Section	Made new	W 0 7 N 21 W 33 1/2
Re-entered	NE "	Corner	W 0 6 S 50 1/2 E 33 1/2 Stone x Mk
"	N 1/4 "	"	Red 0 8 N 5 W 57
Original	E 1/4 "	"	W 0 7 S 61 W 67
"	W 1/4 "	"	Stone at Corner x Mk
			W 0 6 N 89 W 87
			Other true gone
			Red 0 12 S 25 E 25
			W 0 13 N 69 1/2 W 85

Subdivisions corners

# 1	Bo 20 S 77 1/2 E 28
# 2	W 0 14 N 68 W 24
" 4	Stake at Corner
" 5	" " "
" 7	" " "
" 8	" " "
" 10	W 0 10 East 14 1/2
" 18	Stone at Cor x Mk
" 18	W 0 12 S 43 1/2 W 125
" 19	Stone at Corner x Mk
" 19	W 0 12 S 43 1/2 W 106
" 20	Stone at Cor x Mk
" 20	W 0 12 N 66 1/2 W 24 1/2
" 21	Stone at corner
" 21	fo 10 N 87 E 7
" 22	Stone x Mk
" 22	" " "

Sworn Assistants
Chainmen
Hiram Hall
John Zahite
Flagmen
H. Hiles
John Graham
A. H. Birkhathy
Assessors
Leslie Organ
Perry Sisson
Frank Tipt

Witness my hand this 5th day May ad 1902
Fred A. Holden
S. Surveyor