


E 1/2 sections 16 town 17

Range 4 West

Sec 5<sup>o</sup> East

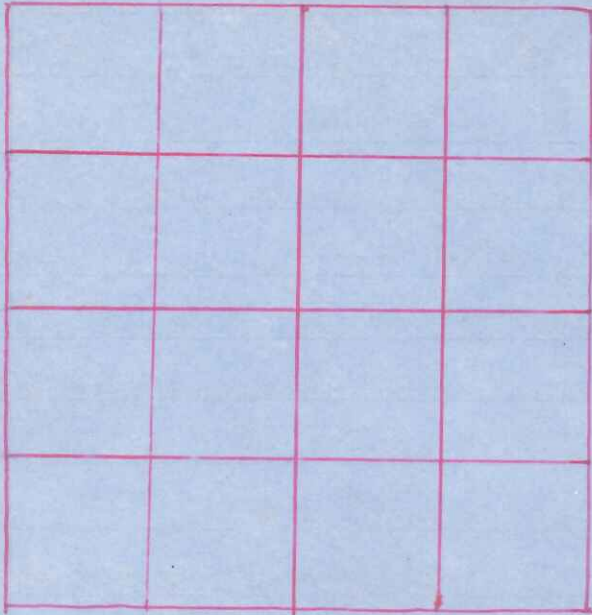

State of Wisconsin  
 County of Monroe } ss  
 I Paul A Holder Surveyor in and for County and State aforesaid certify that I have surveyed and subdivided the East 1/2 of sections 16 town 17 range 4 West done in accordance with State laws and the Field Notes of Original Govt Survey April 25<sup>th</sup> & 26<sup>th</sup> ad 1902

Field Notes

Original	NE sections	Corners	W 0 14 S 27 E 82
Re	SE	" "	W 0 12 S 69 W 61
			fo 12 N 33 1/2 W 68
			fo 14 S 85 W 83
Original	N 1/4	" "	B 0 5 S 88 E 53
	E 1/4	" "	Other tree gone
	S 1/4	" "	W 0 11 N 6 1/2 E 75
		" "	Red 0 6 N 41 W 31
		" "	B 0 9 S 62 W 99
		" "	fo 18 N 86 W 71

Subdivision Corners

	W 0 6 S 67 W 3
* 7	W 0 6 N 55 W 36 1/2
	W 0 10 N 9 W 113
" 8	Stone x mk
	fo 6 N 29 E 50
" 9	fo 5 S 34 W 43
	Old B 0 8 S 21 E 64
" 10	Stone x mk
" 11	W 0 20 N 30 1/2 W 67
" 12	W 0 6 N 77 1/2 W 19
	fo 6 N 21 1/2 W 60
" 14	W 0 6 N 15 1/2 E 64 1/2

Sworn Assistants

- Chairman
- H A Oakley
- Joseph Scudder
- Flagman
- J W Reed
- Holder

Witness my hand this 19<sup>th</sup> day of May ad 1902

Paul A Holder  
 Sec Surveyor

State of Wisconsin )

County of Monroe )

I Paul A Holder Surveyor in and for County and State aforesaid do certify that for Danl Keeler I have surveyed and reestablished the corners of Sec 6 & 7 town 16 R 3-2 and of Sec 1 & 12 town 16 R 4-W done by running the Town Line from 1/4 part between Sec 7 & 12 to the corner of Sec 1 & 6 final distance same as in original govt survey reestablished in accordance therewith Making new B line for recstab corner fo 5 N 10 E 5 the  
 Chairman Chas Oakley Flagman Danl Keeler  
 McCumber

Witness my hand this 1<sup>st</sup> day of October ad 1903

Paul A Holder Sec Surveyor