


N 1/2 of Sec 14 Town 19
Range 2 West

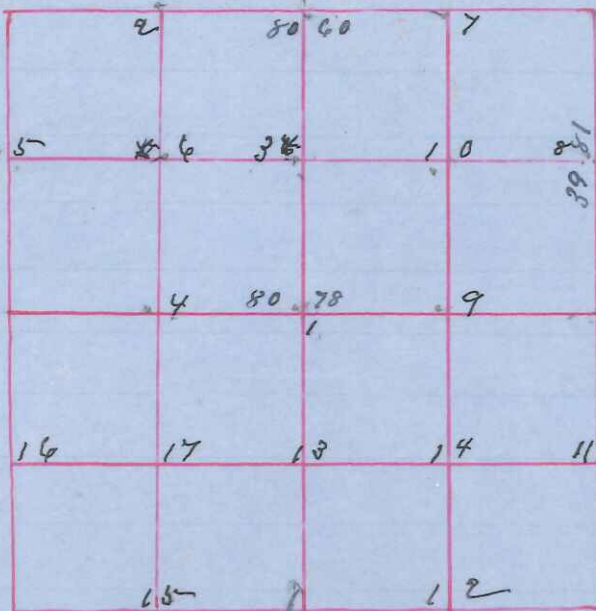

Sec 5-15-E

State of Wisconsin
County of Monroe JSS
I Paul A Holder Surveyor in and
for County and State aforesaid
certify that I have surveyed and sub-
divided the North 1/2 of sections 14 Town
19 Range 2 West done in accordance
with State laws and the field notes
of Original Govt Survey
April 15th 16th + 17th ad 1902

Field Notes

- Realtab NW Section Corner W0 14 N47 1/2 W 96
Red 0 14 S 64 E 58 Stone x Mk 0 3
W0 7 N 21 20 33 1/2
- Original NE " " W0 5-65 0 1/2 E 33 1/2
- Realtab N 1/4 " " Stone at Corner x Mk
Red 0 12 S 25 E 25-
- Original E 1/4 " " W0 13 N 69 1/2 W 35-
- Original S 1/4 " " W0 7 N 49 W 9
W0 10 S 6 1/2 E 16 Stone x Mk

Subdivisions Corner

- # 1 W0 10 N 150 E 87
W0 10 S 44 E 104 1/2 " " "
- " 2 Stone at Corner x Mk
- " 3 " " " " Sworn assistants
- " 4 " " " " Chairman
- " 5 Stake Hiram Hall
- " 6 Stake John Zohrte
- " 7 Stone " " Flagmen
- " 9 " " " Mary Miles
- " 10 Stake John Grabaus
G H Birkhally

Attest
Leslie Organ
Perry Birren

Witness my hand this 19th day of May ad 1902
Paul A Holder
Co Surveyor