


Section 11 Town 18
Range one West

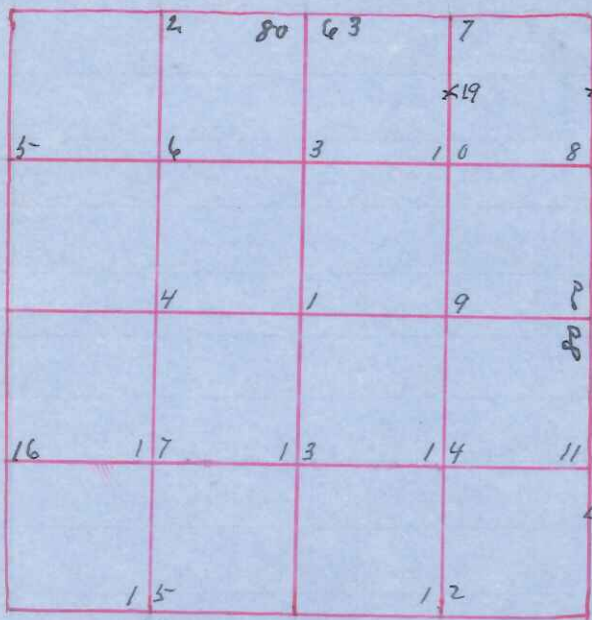

State of Wisconsin
County of Monroe } ss
I, Fred A. Holden, Surveyor in and for
County and State aforesaid do certify
that I have surveyed a part of Section
11 Township 18 Range one West done
in accordance State laws and field
Notes of Original Sout Survey
July
July 28th 29th 30th 31st + Aug 1st ad 1902

Sec 5° 30' E

- Field notes
- Original N & W Sec Corner Bo 10 N 51 E 36
 - Restab N E " " Other tree gone
 - Original S E " " 1 stump 0.15th tree Maple 3 826 1/2 E 37
 - S W " " Jo 4 N 37 E 14
 - Original N 1/4 " " Bo 8 N 58 E 140
 - Bo 6 S 17 W 125
 - Jo pine 11 S 64 W 4
 - Jo oak 8 N 67 W 12

- Subdivision Corners
- #7 Bo 5 N 76 1/2 W 115
 - 2 1/2 in pipe at corner
 - " 8 Stake
 - " 18 "
 - " 19 "
 - " 20 "

- Sworn Assistants
- Chairman
- L R Jennings
 - George Heiser
 - L Thompson
 - H B Tuttle
- Flagmen
- Scott Mokey
 - Ed Sherwood
- Assesors
- Henry Nahw
 - Charley Smoke

Witness my hand this 5th day of August ad 1902
Fred A Holden
Co Surveyor