


N 1/2 Sections 18 town 19
Range one west

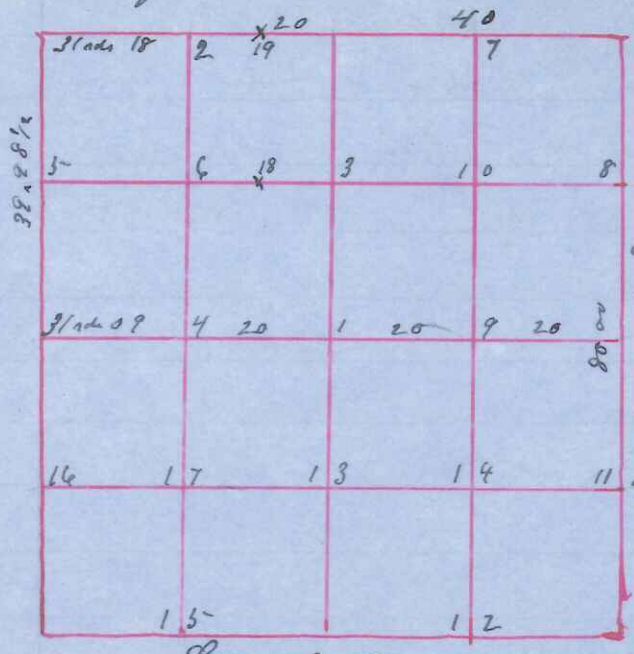

State of Wisconsin }
County of Monroe } SS
I Paul A. Holden Surveyor in and
for County & State aforesaid do
certify that I have surveyed and
subdivided the N 1/2 of sections
18 town 19 Range one west done
in accordance with State Laws
and field notes of Original Govt
Survey May 8th 9 & 10th ad. 1902

Dec 5° 30' E

- Original
- NW Sec Corner
 - NE " "
 - N 1/4
 - E 1/4
 - W 1/4

- Red 0 8 N 5 1/2 W 5 1/2
- Wo 7 8 1/2 W 2 1/2
- Jo 5 8 15 W 2 6 1/2
- Jo 5 8 17 1/2 E 30
- Wo 8 South 10
- Elm 8 8 79 1/2 E 69
- " 7 8 13 E 116 1/2
- Wo 6 N 89 20 37 other true gone

- Subdivision Corners
- # 1 Red 0 6 N 3 1/2 W 19
 - " " 6 N 5 E 33
 - " 2 Wo 8 N 79 1/2 W 45
 - " 7 Stone at corner x Mk
 - " 8 " " " "
 - " 9 Wo 6 N 45 E 2 1/2
 - " 10 2 in iron pipe at corner
 - 26 " 18 1 1/2 " " "
 - 27 " 19 Wo 10 N 27 E 20

- Sworn Assistants
- Chairman
 - Viram Hall
 - Eurtis Beck
 - Flagmen
 - George Rudolph
 - Will Hoffmann
 - Attnes
 - Pete Blifford
 - E Skuldern

Witness my hand this 16th day of September 1902
Paul A. Holden
Co Surveyor