


Section 4 Town 19
Range 3 West

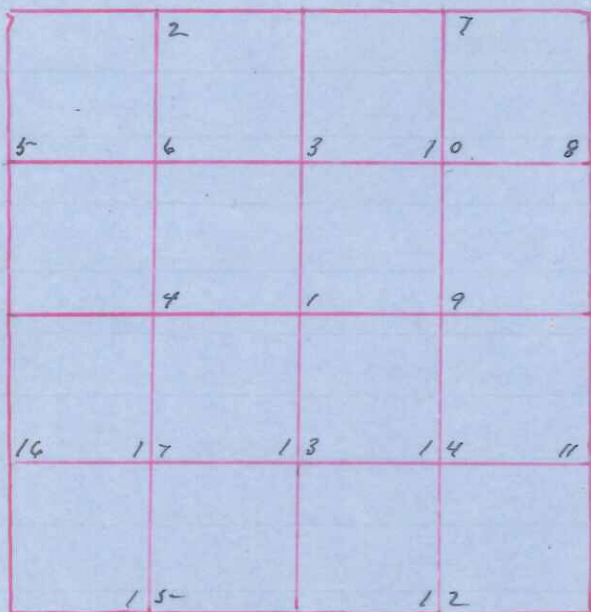

Sec 5th E

State of Wisconsin
County of Monroe J.S.S.
I Paul A. Holden Surveyor in and for
County & State aforesaid do certify that
I have surveyed Section 4 Town 19
Range 3 West accordance with
State laws and the field notes of the
Original Sub Survey May 1st 2nd & 8th
ad 1902

Field notes

- Original NW Section corner Stone & mk
Iron pipe
to 6 S 64 1/2 E 66
- Original SE " " Stone & mk
Random Stake
- Original SW " " Creek North 9th 15th Creek East 7 rods
Pine 14 N 14 W 17 other tree gone
- Original N 1/4 Stone & mk
to 5 N 5 3/4 E 11
- Relates S 1/4 to 4 S 86 E 10

- Subdivision corner
to 12 N 10 W 5
- # 3 Stone & mk
- " 8 to 4 S 79 E 18
- " 10 Stone & mk
- " 11 to 6 N 38 W 22
- " 12 to 5 S 30 1/2 W 22
to 6 S 15 E 9
- " 13 Stone & mk

Sworn Assistants

Chairman

E Jerome

Oliver Turner

Flagmen

Leonard Jerome

George Turner

Witness my hand this 17th day of September ad 1902

Paul A. Holden

Surveyor