


Sec 11, Town 19  
Range 2 West

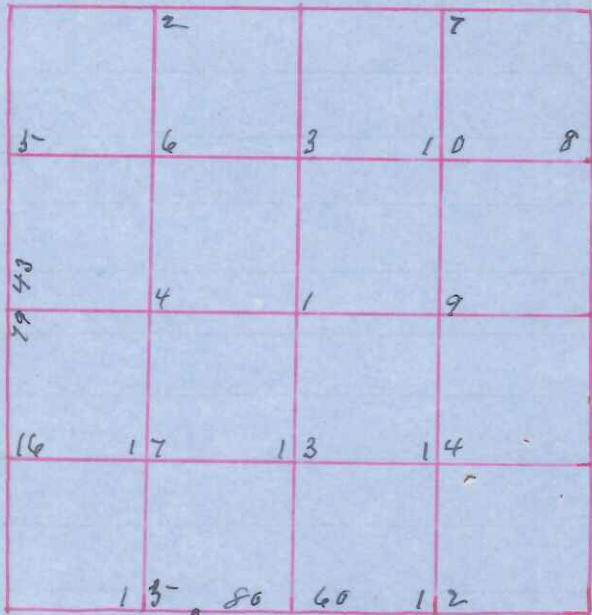

Sec 5° 30'

State of Wisconsin  
County of Monroe J.B.S.  
I Paul A. Holden Surveyor in and  
for County and State aforesaid do  
certify that I have surveyed and  
subdivided Section 11 Town 19  
Range 2 West done in accordance  
with State Law and the field  
notes of original govt Survey  
April 18<sup>th</sup> 19<sup>th</sup> 21<sup>st</sup> & 22<sup>nd</sup> 1902

Field Notes

Original	NW section corner	W Pine 9 N 32 E 15-
Re-established	NE "	Stone x MK To 7 577 W 44
Original	SE "	new trees Red 0 6 5 7 1/2 E 30 W 0 7 N 21 W 33 1/2
Re-established	SW "	Red 0 14 5 6 9 E 58 Stone x MK To 6 5 5 5 E 43
"	N 1/4 "	To 6 5 5 W 23
"	E 1/4 "	W 0 12 N 9 1/2 E 39
"	S 1/4 "	W 0 5 5 8 9 W 16
"	W 1/4 "	Stone at cor x MK To 5 5 7 3 E 9
"	"	W 0 5 N 5 8 1/4 E 18 1/2

Subdivisions Corners

Sworn assistants

" 1	Stake at corner	Chairmen
" 3	W Pine 9 557 E 73 Pine skins at corner	Hiram Hall
" 7	Stake at corner	John Zahrt
" 8	Stone To 6 N 23 W 48 " x MK	Olaf Hagamen
Stone x MK	To 8 S 46 W 77 Red 0 7 2 37 1/2 W 3	Harry Miles
" 11	" " 4 N 63 1/2 W 2 1/2	John Graham
" 12	Stone at cor x MK W 0 2 0 S 12 1/2 W 72	E. H. Birkhally
" 13	To 8 S 86 1/2 E 16 1/2 To 4 N 39 E 4	Damen
" 14	W 0 10 S 11 W 16	Leslie Oregon
" 15	Stone at cor x MK	
" 16	" " " Dead Pine 24 N 57 1/2 E 8	Frank Left
" 17	W 0 5 N 5 5 E 6	

Witness my hand this 18<sup>th</sup> day of Sept ad 1902  
Paul A. Holden  
Co Surveyor