


Sec 12 Town 19
Range 2 West

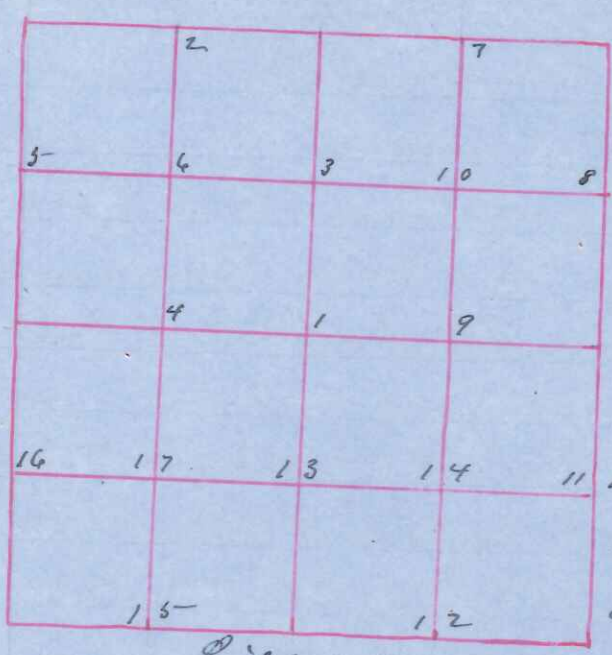

Sec 5-30'

State of Wisconsin }
County of Monroe } SS
I Paul A. Halder, Surveyor and
for County and State aforesaid do
Certify that I have surveyed and
subdivided sections 12 Town 19
Range 2 West done in accordance
with State laws and the Field notes
of Original Govt Survey
April 21st and 22nd ad 1902

Field Notes

Retalab	NW section	Corner	fo 7 S 77 W 44 Red 0 6 S 1 1/2 E 30 wo 8 N 8 1/2 W 132
"	NE	"	fo 6 S 16 20 71 Red 0 8 N 5 20 57
"	SE	"	fo 7 S 6 1 W 67 wo 7 N 2 1 W 33 1/2
Original	SW	"	wo 5 S 50 1/2 E 33 1/2
Retalab	N 1/4	"	fo 6 East 4 Money Pine 14 S 5 1/2 E 160
"	E 1/4	"	wo 12 S 5 W 155
"	S 1/4	"	Stone at corner x MK
"	W 1/4	"	wo 12 N 9 1/2 E 39 wo 5 S 89 W 16

Subdivision Corners

# 1	fo 6 S 5 3/4 W 55	Stone x MK
" 2	Stake at corner	
" 4	Stone " " x MK	
" 5	" " " "	
" 6	fo 6 N 4 1/2 W 52	
" 7	Stake at corner	
" 8	" " " "	
" 9	Stone " " x MK	
" 12	Stake " " " "	
Stone x MK	wo 12 N 83 E 54	
" "	fo 6 N 57 W 79	
" "	Red 0 7 S 37 1/2 W 54	
" "	fo 6 N 57 W 79	
" "	fo Pine 5 S 6 1/2 W 8	
" 17	Stone x MK	

Sworn Assistants

- Chairmen
 Miriam Hall
 John Zohite
 Flagman
 Harry Miles
 John Graham
 G. H. Birkholtz
 Examiners
 Leslie Organ
 Perry Sisson
 Frank Gift

Witness my hand this 19th day of Sept ad 1902
 Paul A. Halder
 Co Surveyor