


Sec 31 Town 19  
Range 3 West

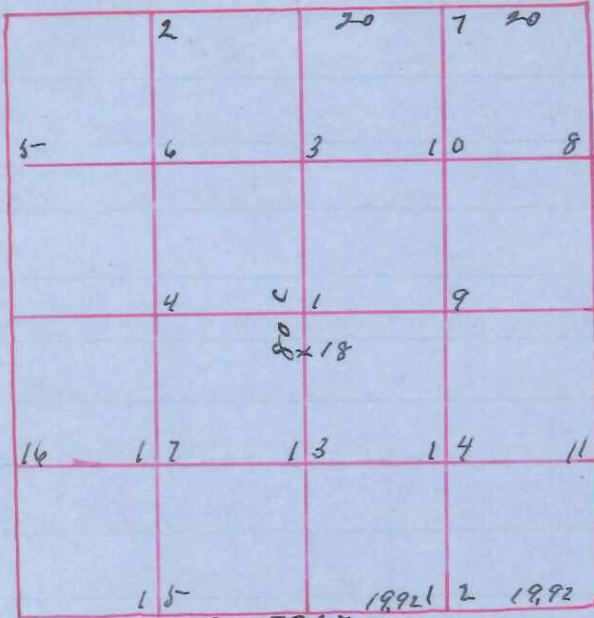

State of Wisconsin  
County of Monroe 365  
I Paul A Holden Surveyor in  
and County and State aforesaid  
do certify that I have surveyed  
and subdivided the E 1/2 of section  
31 town 19 Range 3 West done in  
accordance with State Laws and  
the Field Notes of Original Govt.  
Survey Sept 23<sup>rd</sup> 24<sup>th</sup> & 25<sup>th</sup> Oct 1902

79.47  
Field Notes

N to Sec corner

Original

- SE " " No 8 S 4 1/2 E 215  
Set old gum barrel at corner  
Set when 3<sup>rd</sup> tier corner as 1<sup>st</sup> division
- NE " " 4 in Iron Pipe at corner  
Bo 12 N 52 W 18
- SW " " Bo 9 S 65 E 36 (down)  
Iron + Stake at corner
- N 1/4 " " X on Sandstone ledge S 3 1/4 W 60 1/2
- E 1/4 " " Pile Red Sandstone north 3 ft
- S 1/4 " " Iron Skins at corner
- W 1/4 " " "

Subdivision corners

- # 1 Jo 4 S 74 1/2 E 8
- 113 Stone at corner X NK
- " 7 Square Jo 10 for corner  
Jo 4 S 8 1/2 W 18
- " 9 Iron bar 1 in x 2
- " 10 " " 2 1/2 x 1/2
- " 13 Jo 6 S 39 E 18
- " 18 Wo 12 S 60 W 45

Sworn Assistant

Chairman

Thomas Fletcher

Peter Hill

Flagman

James Fletcher

Sullivan "

Attest

Burt Dayton

Thomas Fletcher Sr

Witness my hand this 29<sup>th</sup> day of Sept 1902

Paul A Holden

Co Surveyor