


Sec 29 Town 18
Range one west

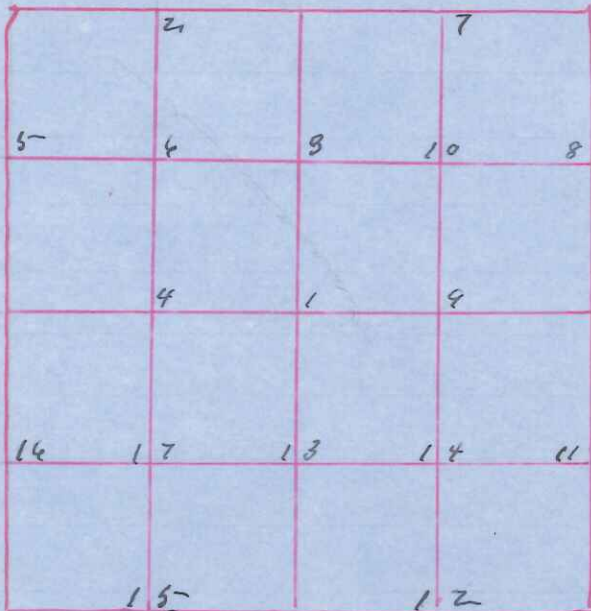

Sec 6° 30' E

State of Wisconsin }
County of Monroe } SS

I Paul A Holden Surveyor in and for County and State aforesaid do certify that I have surveyed and subdivided the West 1/2 of sections 29 Township 18 Range one West done in accordance with State Law and the Field notes of Original Govt Survey May 22nd and 23rd 1902

Field notes

- Stone x MC NW Sec Corner fo 8 N 43 E 20
- " " SW " " " " Dtl No 7 N 39 W 37
- " " E 1/4 " " " " No 12 N 42 1/2 W 131
- " " W 1/4 " " " " fo 12 S 4 W 140
- " " " " " " " " fo 20 S 46 1/2 W 46
- " " " " " " " " fo 12 S 86 E 95-

Subdivision Corners

- # 1 Chainy 6 S 83 1/2 W 77
- " 4 fo 5 N 82 W 23
- " 5 3 1/2 in Pump Cylinder at corner
- " 6 Iron Rod " "
- " 15- fo 18 N 86 1/2 W 24 1/2
- " 16 fo 8 S 70 E 59
- " 16 fo 7 N 15 1/2 E 64

- Sworn Assistants
Chairmen
- Charles Shutter
 - L B Bailey
- Plagamen
- Ed Koopman
 - Lewis Rosenthal

Witness My hand this 7th day of October ad 1902
Paul A Holden
Surveyor