


Sections 12 Town 18
Range one west

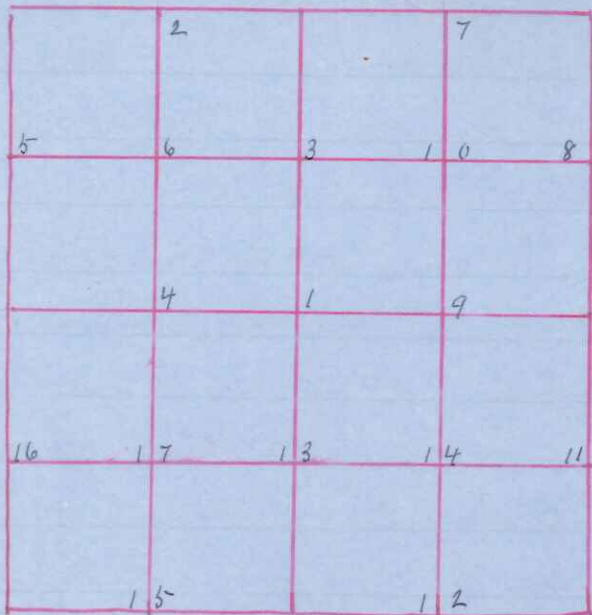

State of Wisconsin
County of Monroe JSS

I Fred A Holden Surveyor in and for County and State aforesaid do certify that I have surveyed the East 1/2 of Section 12 Town 18 Range one West done in accordance with State laws and the field notes of Original Survey Nov 23rd & 24th ad 1903

Dec 6th 12 E

Field Notes

Re-estab 1902

NW Section corner *Maple 3 S 26 1/2 E 37 fo 4 N 37 E 14*

" NE " " Stake

" SE " " 1/4 in pipe at corner

Original SW " " *fo 6 S 83 1/2 E 64 fo 5 S 82 E 95*

by Stumps & B. Hus

N 1/4 " " Stake

E 1/4 " " "

S 1/4 " " "

Sworn Assistants

Subdivision Corners

Chairmen

1 Iron Pipe at corner

Robert Jones

" 3 Stake " "

Charles Edwark

" 8 No 20 N 79 1/2 E 8

Flagman

" 9 Stake at corner

Will Mahley

" 10 " " "

Charles Anderson

" 11 " " "

Atmen

" 12 fo 5 S 67 1/2 E 68

Henry White

" 14 Stake

Living Edwark

Witness my hand this 2nd day of Feb ad 1904

Fred A Holden

Co Surveyor