


Sec 5 town 18  
Range one East

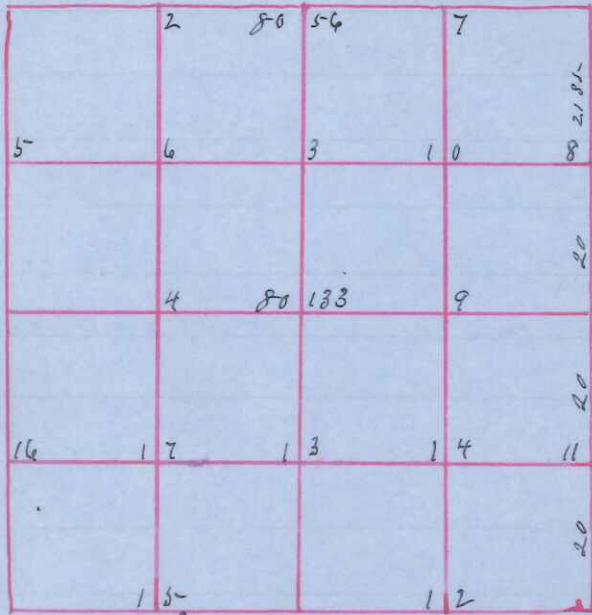

Dec 4° 30'

State of Wisconsin  
County of Monroe J.S.S  
I find a Holder Surveyor in and for  
County and State aforesaid do certify that  
I have surveyed and reestablished the  
the North and East lines and the East  
and West 1/4 line of sections 5 town  
18 range one East done in accordance  
with state Law and the Original Field  
note of the Original Govt survey Jan  
20<sup>th</sup> 21<sup>st</sup> 23<sup>rd</sup> ad 1903

Field notes

- Original NW Section Corner  
 " NE " " by Stump 4 Original B tree  
 " SE " " known to be the original cor  
 " SW " "  
 acstab N 1/4 " " of Pine 16 S 15 1/2 E 138 1/2  
 " E 1/4 " " W Pine 16 S 82 W 68  
 " W 1/4 " " Stake kept up

- | Subdivision | Corner                     | Sworn Assistants |
|-------------|----------------------------|------------------|
| # 1         | Stake south 2 1/2          | Chairman         |
| " 2         | " at Corner                | W. F. Riley      |
| " 4         | " " "                      | Ernest Olson     |
| " 7         | W P Stump 24 S 82 1/2 E 39 | Flagmen          |
| " 8         | W Pine 14 S 83 1/2 W 57    | W. Johnson       |
| " 8         | W Pine Stump 24 N 44 E 28  | Robt Jones       |
| " 9         | Stake at Corner            | Almer            |
| " 11        | " " "                      | Dan Rose         |
| " 13        | " " "                      |                  |
| " 14        | " " "                      |                  |

Witness my hand this 24<sup>th</sup> day of Jan ad 1903  
 Fred A Holder  
 Co Surveyor