


Sections 25-Town 17
Range 4 West

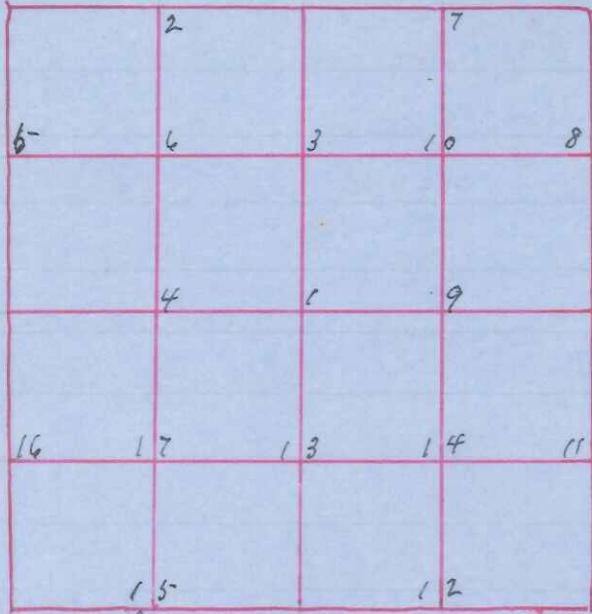

Dec 5° East

State of Wisconsin
County of Monroe J.S.S.
I Fred A. Holder Surveyor in and
for County and State aforesaid do
certify that I have surveyed and
subdivided the North 1/2 of sections
25-Town 17 Range 4 West done in
accordance with State laws and
the Field notes of original Govt Survey
Oct 27th ad 1902

Field notes

Original NW Section Corner Stake Center Highway
NE " " Br 07 S 13 W 47
NW 1/4 " " Stake
" " New Run Jo 6 S 81 E 207
Original E 1/4 " " Jo 10 S 73 E 187
" Stone x mk SW 1/4 " " Del 130 6 East 82
" " " " Br 07 S 80 W 64

Subdivision Corners

Stone x mk * 1 Jo 18 N 0° 10' East
" 3 Stone at cor x mk
" 4 1/4 Pipe at corner
" 5 Stone x mk
" 6 1/4 Pipe at corner
" 7 old Iron at corner

Sworn assistants

Chairman
F. A. Holder
Julius Fiskie
Flagman
Fred Fiskie

Witness my hand this 28th day of January ad 1903
Fred A. Holder
Co Surveyor