


Sec 28 Town 18
Range 3 West

Sec 5^o East

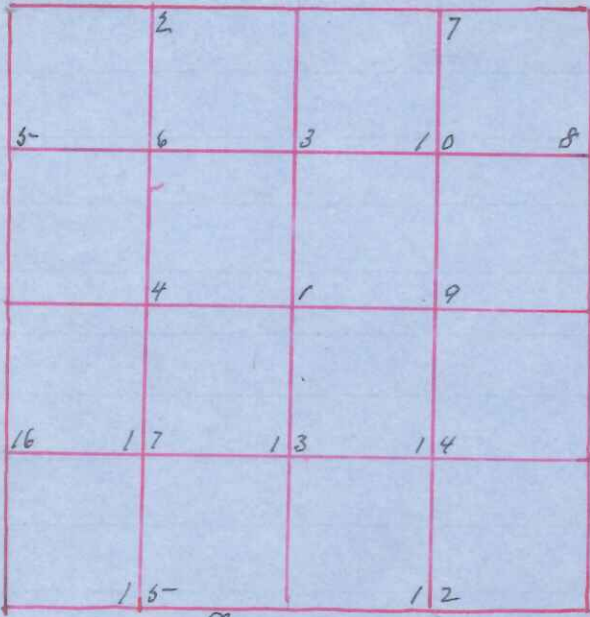

State of Wisconsin,
County of Monroe } ss
I Paul A Holder Surveyor in and
for County and State aforesaid do
Certify that I have surveyed and sub
divided the South 1/2 of section 28 Town
18 Range 3 West done in accordance
with State Laws and the Field Notes
of Original Govt Survey
Nov 5th and 6 ad 1902

Field Notes

- Original NW 1/4 Sections corner Stone at corner placed when 13 trees were standing
- Restab SE " " 1 Pine 10 S 62 1/2 E 98
- Original SW " " 1 Br 0 20 N 12 1/2 E 197 1/2
- " E 1/4 " " Stone at corner
- " " " " 1 Pine 14 N 58 1/2 W 88
- Restab S 1/4 " " " " 16 S 32 E 14
- " W 1/4 " " Stone at corner x mk
- " " " " 1 Br 0 24 S 45 1/2 W 57 1/2

Subdivision Corner		Sworn Assistants
# 1	1 1/4 in Pipe at corner	Chairman
" 4	" " "	John Boyer
" 5	Stone at corner x mk	Chas Smith
" 9	1 1/4 Pipe at corner	S A Bailey
" 11	Stone at corner x mk	Flagmen
" 12	" " "	J C Greenlee
" 13	" " "	J A Brown
" 14	Stone 6x8x12 down 18 in	
" 15	" at corner x mk	

Witness my hand this 9th day of Feb ad 1902
Paul A Holder
Co Surveyor