


Section 30 Town 18  
Range 3 West

6° East

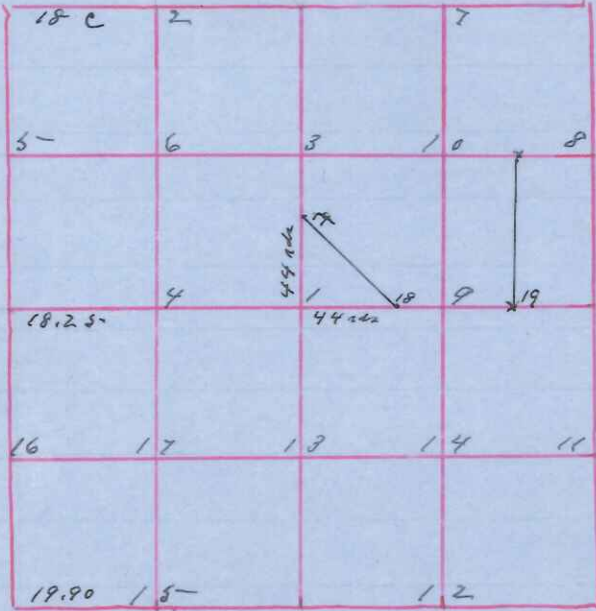

State of Wisconsin  
County of Monroe J.S.  
J. Paul A. Holden Surveyor in and  
for County and State aforesaid do  
Certify that I have surveyed the  
North 1/2 of section 30 Town 18 Range  
3 West done in accordance with  
State laws and the Field notes  
of Original East Survey  
Dec 5<sup>th</sup> 1879 Feb 11<sup>th</sup> ad 1903

Field notes

Original NW section corner No 11 S 73 E 132 other tree gone  
" NE " " B20 9 S 2 1/2 W 27  
Recital 1899 N 1/4 " " No 12 N 62 W 30  
Original E 1/4 " " No 15 N 60 W 18  
" W 1/4 " " No 6 S 65 W 48  
" " " " No 10 N 18 W 100

Subdivision corners

1899 # 1 No 12 N 9 W 83  
No 6 S 55 W 20  
No 12 N 11 E 44  
# 2 No 14 S 1 E 11  
No 18 East 25-  
" # 3 No 3 S 38 1/2 W 15-  
No 10 N 60 E 96  
" 4 No 10 S 5 E 90  
No 6 N 45 W 97  
1899 " 7 No 15 N 75 E 137  
No 6 N 88 E 24  
" 18 No 6 S 5 W 93  
No 10 S 61 W 7  
" 19 No 8 N 27 1/4 E 31

Sworn assistants

Chambers

Uriah Jones 1903  
Frank Cale "  
N. C. Rohde 1899  
R. H. Howe "

Flagmen

Joseph Sargent 1903  
Ray Jones "  
Austin Wright 1899  
Webb Noble "

Witness my hand this 16<sup>th</sup> day of Feb ad 1903  
Paul A. Holden  
Co Surveyor