


Sec 33 Town 18
Range one East

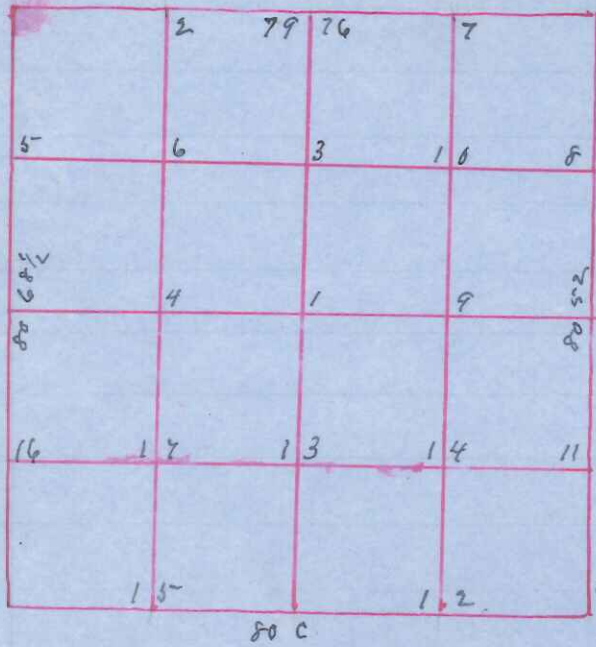

Sec 50 East

State of Wisconsin
County of Monroe } S.S.
I Fred A. Holder Surveyor in and
for County and State of aforesaid do
Certify that I have Surveyed and
Subdivided Section 33 Town 18
Range one East ^{one} in accordance
with State laws and the Field notes
of Original Supt Survey
Dec 31st 1902 Jan 1st 2nd & 3rd 1903

Field notes

Reestablish	NW Section corner	Stones x MK
"	NE	" "
"	SE	" "
Original	SW	by Stumps of Original 4 B trees
Reestablish	N ¹ / ₄	Stone x MK
	E ¹ / ₄	Stake at corner
	S ¹ / ₄	Stone x MK
	W ¹ / ₄	" "

Subdivision corner

Section	Stake at corner	Stones x MK	Stones x MK
4	Stake at corner		
7	Stones x MK		
11	" "		
13	" "		
14	" "		
16	" "		

Sworn assistants

Chairman

Wm Sutherland

Herman Willey

Flagmen

Henny Straub

Chas Gray

Amen

Will Jones

Geo Goldschmidt

Witness My hand this 30th day of March ad 1903

Fred A. Holder

Co Surveyor