


Section 12 Town 19  
Range one East

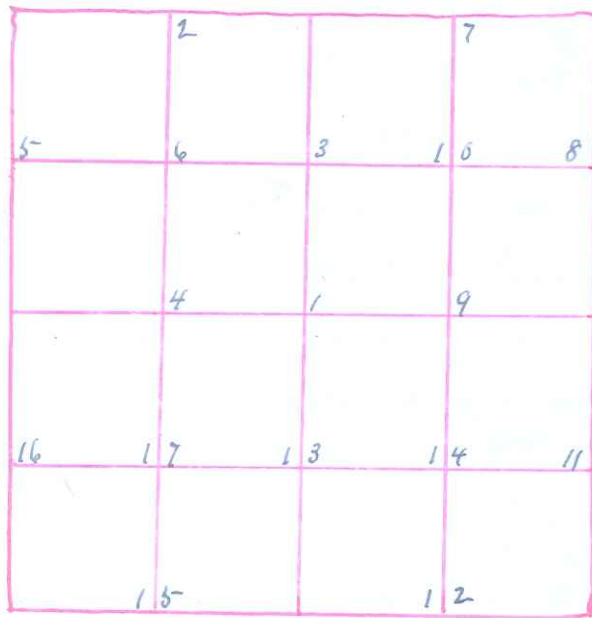

Sec 5 E

State of Wisconsin,  
County of Monroe J.S.S  
I Paul A. Holden Surveyor in  
and for County & State aforesaid  
do certify that I have surveyed and  
subdivided Section 12 Town 19 Range  
one East done in accordance with  
State laws and the field notes of  
Original Govt Survey  
March 10<sup>th</sup> 11<sup>th</sup> and 12<sup>th</sup> ad 1903

Field notes

- Original NW Section Corner Iron angle bar at corner
- " NE " " Stone 18x12x9xMC
- " SW " " Norway 8 N 48 1/2 E 5-9
- " " " " 8 N 82 20 W 65-
- Re-estab N 1/4 " " of Pine 10 N 88 E 4
- " W 1/4 " " RR Rail at corner

Subdivisions Corner

- # 2 Jo 5 N 40 1/2 E 4  
of Pin 6 N 46 1/2 W 5-4
- " 4 Jo 5 South 25-
- " 5- Cross Couple Pin at corner  
Jo 3 N 45 E 6
- " 6 Jo 3 N 45 W 7
- " 7 RR Rail at corner
- " 16 Jo 7 N 50 3/4 E 60
- " 17 Jo 6 N 71 W 10

- Sworn assistants
- Chairmen
- L. L. Cook
- Noble Goldsmith
- Flagmen
- Peter Olson
- Lawrence Cook
- Axmen
- Nels Olson
- Will Babcock

Witness my hand this 1<sup>st</sup> day of July ad 1903  
Paul A. Holden  
Co Surveyor