


Section 20 Town 19
Range one East

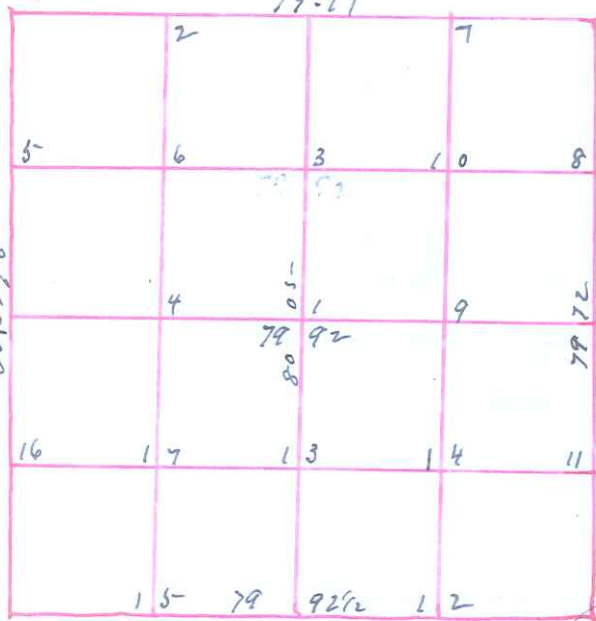

State of Wisconsin,
County of Monroe SS
I Paul A. Halderm Surveyor in and
for County & State aforesaid do Certify
that I have surveyed and subdivided
Section 20 town 19 Range one East
done in accordance with the Terms
of section 8272 Statutes 1898 Laws 1901
and the Field notes of Original Loc. Survey
June 10th 11-12-13-14-15th ad 1902.

Original	Field Notes
Stones & mark N & W Section Corner	W Pine 10 S 72 W 33 Stone Mkd W South 34 W Pine 12 N 24 E 29 " " " West 21 Jo G S 50 W 175-
" NE	Jamaea 6 N 5-4 3/4 W 12 1/2
" SE	Witness Stone S 40 W 71 1/4
" SW	" Pine 12 N 58 1/4 E 116 1/2
" N 1/4	Jo E S 5 N 46 W 114 1/2
" E 1/4	Witness Stone West 20
" S 1/4	" " N 45 W 71 1/2
" W 1/4	Jo G S 5-9 1/2 W 17 1/4
	Witness Stone North 50
	" " South 50

Subdivision	Sworn Assistants
Stones & Mkd # 1 Jo 4 South 69 1/2	Chairman
" 2 Jo 5 S 76 W 182	Miram Hall
" 3 W.P. Stump 10 N 50 3/4 E 25 1/2	Charles Gray
" 4 Jo 6 S 44 1/2 W 195-	Flagman
" 5 Stake at Corner Mkd 3	Wm Gray
" 6 W.P. Stump 10 N 8 E 47	" " Jr
" 7 Jo G N 47 W 26	Armen
" 8 Jo G N 56 1/2 E 55-	W E Green
" 9 Jo 5 N 59 W 13 1/2	S Jover
" 10 W.P. Pine 6 N 89 1/2 E 68	
" 11 Stone & Mkd West 1 1/2 link	
" 12 Stake at Corner Mkd 15-	
" 13 " " " " 14	

Witness My hand this 18th day of July ad 1903
Paul A. Halderm
Geo Surveyor